

Registration Statement

OF CLAIMANT OF RIGHT TO APPROPRIATE GROUND WATER

TO THE STATE ENGINEER OF OREGON:

I, J. Francis Whitney

of 365 Debrick Road, Eugene County of Lane

(Mailing address)

State of Oregon, do hereby make application for a certificate of registration as evidence of a right to appropriate ground water.

1. Source from which water is withdrawn is Pump well
(Flowing well, pump well, infiltration trench, or tunnel)

2. Location is: 1 mile north of Eugene
(Approximate distance and direction from nearest city or town)

and is more particularly described as follows:

(a) 850 ft. North, 2400 ft. West of section corner
(Give distance and bearing to corner of section or other legal subdivision)

being within SW 1/4 of SE 1/4 of Sec. 19 Twp. 17 S Rge. 3 W
(Smallest legal subdivision) (N. or S.) (E. or W.)

or (b) within limits of recorded platted property, town or city:

in Lot 5, Block --- of Debrick Gardens
(Name of plat or addition)

County of Lane
(If within city or town, give name)

3. Construction Work was begun on Spring 1950; was completed on Spring 1950
(Date) (Date)

and the ground water claimed was first used for the purposes set out below on Summer 1950
(Date)

since which time the water has been used Continuously.
(Continuously or intermittently)

from 1950 to 1957
(Date) (Date)

4. Quantity of water claimed and used is 30 gallons per minute; _____ acre feet per year.

5. Purpose or Purposes for which water is used Domestic and Irrigation

(Domestic, irrigation, municipal, manufacturing, industrial, etc.)

6. Description of Well: Depth 86 feet. Type Drilled
(Dug or drilled)

diameter 5 inches. Elevation of ground at well site 450 feet, mean sea level.
(As near as known)

Depth to water table 39 feet.

7. Capacity of Well: _____ g.p.m. with _____ feet drawdown.

Well furnished 35 g.p.m. when dug. Drawdown was not measured.
_____ g.p.m. with _____ feet drawdown.

Date of test Spring 1950

If Flowing Well: Measured discharge _____ g.p.m. on _____

(Date)

Shut-in pressure at ground surface _____ lbs. per sq. in. on _____

(Date)

Water is controlled by _____
(Cap, valve, etc.)

8. Casing: (Give diameter, commercial specifications and depth below ground surface of each casing size.)

5 inch diameter steel from 0 to 22 feet
inch diameter no casing from 22 to 86 feet
inch diameter from to feet
inch diameter from to feet

Describe and show depth of shoe, plug, adapter, liner or other details: _____

9. Perforated Casings or Screens:

(Number per foot and size of perforations, or describe screen) from to
from to
from to
from to

10. Log of Well: (Describe each stratum or formation clearly, indicate if water bearing, and give thickness and depth as indicated.)

MATERIAL	ft	Thickness (Feet)	Depth to Bottom (Feet)

If log of well is not available, give name and address of driller. _____

Wayne Hayes 535 Colburg Road, Eugene Oregon _____

11. Infiltration Trench: Covered or open _____

Dimensions: Length _____ ft. Minimum depth _____ ft. Maximum depth _____ ft.

Bottom width _____ ft. Discharge _____ g.p.m. Date of test _____

12. Tunnel: Type of lining _____

Dimensions: _____
(Length, course, and cross sectional size)

Position of water bearing stratum with reference to portal of tunnel _____

Log of tunnel: (Preceding table for log of well may be used, if desired. Give footage from portal and character of materials, as pertinent.) _____

13. Pumping Equipment:

(a) Pump Jacuzzi multi-stage jet _____ Capacity 30 g.p.m.
(Make, type and size)


(b) Motor electric 3 h.p. _____
(Type and horsepower)

14. Location of area irrigated or to be irrigated, or place of use if for purposes other than irrigation.

Township North or South	Range East or West of Willamette Meridian	Section	Forty-acre Tract	Number Acres To Be Irrigated	Date of Reclamation
17 S	3 W	19	SW 1/4 of SE 1/4	1.55	1950

15. If the ground water supply is supplemental to an existing water supply, identification of any application for a permit, permit, certificate or adjudicated right to appropriate water made or held by the registrant _____

Township 17S Range 3W, W.M.
North

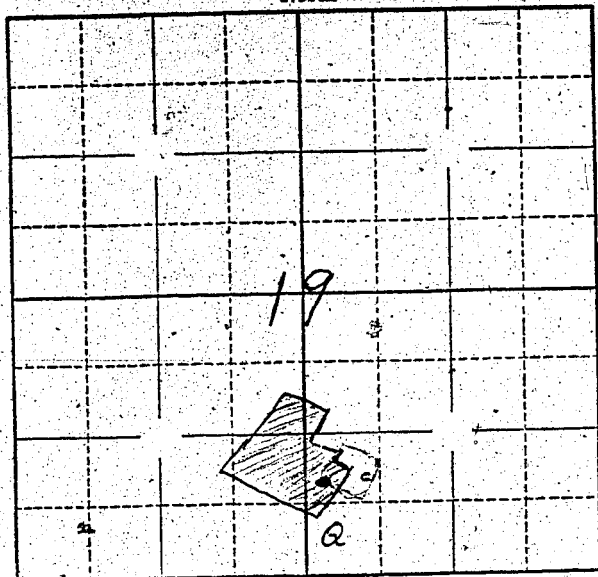

Locate well and acreage of irrigated land on plat.
Scale: 2" = 1 Mile

STATE OF OREGON }
County of _____ Lane _____ } ss.

I, J. Francis Whitney, being first duly sworn, do hereby certify that I have read the foregoing Registration Statement and that all of the items therein contained are true to the best of my knowledge and belief.

J. Francis Whitney
(Signature of Registrant)

Subscribed and sworn to before me this 3rd day of July, 1958.

My commission expires Aug. 17, 1958
Donald F. Robinson
(Notary Public)

(SEAL)

CERTIFICATE OF REGISTRATION

STATE OF OREGON }
County of Marion _____ } ss.

This is to certify that the foregoing Registration Statement was received in the office of the State Engineer on the 7th day of July, 1958, at 9:00 o'clock A.M. and has been duly recorded in said office in Book No. 8 of Registration Statements on page GR-1854

Witness my hand this 26th day of January, 1959.

Lewis A. Stanley
(State Engineer)

#1500

By _____
(Deputy)