

Registration Statement

OF CLAIMANT OF RIGHT TO APPROPRIATE GROUND WATER

TO THE STATE ENGINEER OF OREGON:

I, Sylva Carter

of Route 2, Box 139, Lebanon County of Linn

(Mailing address)

State of Oregon, do hereby make application for a certificate of registration as evidence of a right to appropriate ground water.

1. Source from which water is withdrawn is Pump Well No. 1

(Flowing well, pump well, infiltration trench, or tunnel)

2. Location is: 2 miles NE of Lebanon, Oregon

(Approximate distance and direction from nearest city or town)

and is more particularly described as follows:

(a) N. 17° 40' W. 17.5 chains from SE corner of DLC 57

(Give distance and bearing to corner of section or other legal subdivision)

being within NE $\frac{1}{4}$ of NE $\frac{1}{4}$ of Sec. 35, Twp. 11 S, Rge. 2 W

(Smallest legal subdivision)

(N. or S.)

(E. or W.)

or (b) within limits of recorded platted property, town or city:

in Lot _____, Block _____ of _____

(Name of plat or addition)

County of Linn

(If within city or town, give name)

3. Construction Work was begun on 1942; was completed on 1942

(Date)

(Date)

and the ground water claimed was first used for the purposes set out below on 1942

(Date)

since which time the water has been used continuously

(Continuously or Intermittently)

from 1942 to present time

(Date)

(Date)

4. Quantity of water claimed and used is 250 gallons per minute; 65.25 acre feet per year.

5. Purpose or Purposes for which water is used Irrigation

(Domestic, irrigation, municipal, manufacturing, industrial, etc.)

6. Description of Well: Depth 89 feet. Type Drilled

(Dug or drilled)

diameter 8 inches. Elevation of ground at well site 315 feet, mean sea level.

(As near as known)

Depth to water table 20 feet.

7. Capacity of Well: 400 g.p.m. with 5 feet drawdown.

_____ g.p.m. with _____ feet drawdown.

Date of test 1942

If Flowing Well: Measured discharge _____ g.p.m. on _____

(Date)

Shut-in pressure at ground surface _____ lbs. per sq. in. on _____

(Date)

Water is controlled by _____

(Cap, valve, etc.)

If log of well is not available, give name and address of driller: Marion West, Salem, Oregon

11. Infiltration Trench: Covered or open _____

Dimensions: Length _____ ft. Minimum depth _____ ft. Maximum depth _____ ft.

Bottom width _____ ft. Discharge _____ g.p.m. Date of test _____

12. Tunnel: Type of lining _____

Dimensions: _____
(Length, course, and cross sectional size)

Position of water bearing stratum with reference to portal of tunnel _____

Log of tunnel: (Preceding table for log of well may be used, if desired. Give footage from portal and character of materials, as pertinent.)

13. Pumping Equipment:

(a) Pump Fairbanks Morse 3" Centrifugal Capacity 1400 g.p.m.
(Make, type and size)

(b) Motor 20 H. P. electric
(Type and horsepower)

14. Location of area irrigated or to be irrigated, or place of use if for purposes other than irrigation.

Township North or South	Range E. or W. of Willamette Meridian	Section	Forty-acre Tract	Number Acres To Be Irrigated	Date of Reclamation
11 S	2 W	26	SE $\frac{1}{4}$ of SE $\frac{1}{4}$	5.5	1942
11 S	2 W	35	NE $\frac{1}{4}$ of NE $\frac{1}{4}$	14.9	"
11 S	2 W	35	SE $\frac{1}{4}$ of NE $\frac{1}{4}$	5.7	"
				26.1	

153-619

Beginning at a point which is 120 rods East of the Southwest corner of the Andrew Lees D.L.C. 1199, Claim 69 and 71, and running thence north 122 rods; thence west 59 $\frac{1}{2}$ rods; thence South 122 rods; thence East 59 $\frac{1}{2}$ rods to the place of beginning and containing 45 acres, more or less, all of said land being in Linn County, Oregon.


213-414

Part of Section 35 and Claim No. 57, T. 11 S., R. 2 W. of the Will. Mer. in Linn County, Oregon, more particularly described as follows:

Beginning at the Northeast corner of the Southeast quarter of the Stewart M. Fernington D.L.C. 57; thence West 40 rods to the Northeast corner of a tract of land deeded to W. B. Douglas as described in the deed records in Book 94, page 459 of Deed Records; thence South parallel to the East line of said Claim 173 rods to the center of a county road; thence East along the center of said county road 40 rods to a point 13 rods South of the Southeast corner of said Claim 57, thence North to the Southeast corner of said Claim, thence continuing North along the East line of said Claim 57 to the place of beginning, subject to the rights of the public in roads.

15. If the ground water supply is supplemental to an existing water supply, identification of any application for a permit, permit, certificate or adjudicated right to appropriate water made or held by the registrant.

Township 11 S Range 2 W W.M.
North

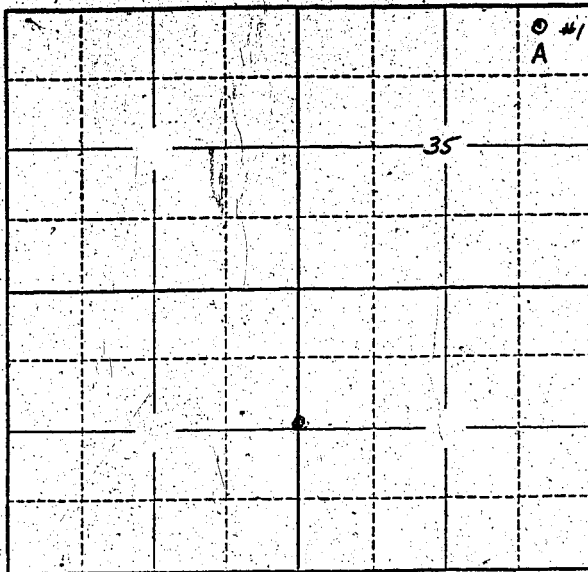

Locate well and acreage of irrigated land on plat.
Scale: 2" = 1 Mile

STATE OF OREGON

County of Linn

} ss.

I, Sylva Carter, being first duly sworn, do hereby certify that I have read the foregoing Registration Statement and that all of the items therein contained are true to the best of my knowledge and belief.

Sylva Carter
(Signature of Registrant)

Subscribed and sworn to before me this 1st day of July, 1957.

My commission expires COMMISSION EXPIRES MARCH 12, 1959

Walter McNamee
(Notary Public)

(SEAL)

CERTIFICATE OF REGISTRATION

STATE OF OREGON

County of Marion

} ss.

This is to certify that the foregoing Registration Statement was received in the office of the State Engineer on the 7th day of July, 1957, at 8:00 o'clock A M. and has been duly recorded in said office in Book No. 8 of Registration Statements on page GR-1855

Witness my hand this 26th day of January, 1959

Laura A. Stanley
(State Engineer)

By _____
(Deputy)

\$15.00