

Registration Statement

OF CLAIMANT OF RIGHT TO APPROPRIATE GROUND WATER

TO THE STATE ENGINEER OF OREGON:

I, Sylva Carter
of Rt. 2, Box 139, Lebanon County of Linn
(Mailing address)

State of Oregon do hereby make application for a certificate of registration as evidence of a right to appropriate ground water.

1. Source from which water is withdrawn is Pump Well No. 2
(Flowing well, pump well, infiltration trench, or tunnel)

2. Location is: 1/4 miles NE of Lebanon, Oregon
(Approximate distance and direction from nearest city or town)

and is more particularly described as follows:

(a) N. 47°50' E. 35.8 chains from SW corner of DLG 71
(Give distance and bearing to corner of section or other legal subdivision)
being within SE 1/4 of SW 1/4 of Sec. 35, Twp. 11 S, Rge. 2 W
(Smallest legal subdivision) (N. or S.) (E. or W.)

or (b) within limits of recorded platted property, town or city:
in Lot _____ Block _____ of _____
(Name of plat or addition)
_____ County of Linn
(If within city or town, give name)

3. Construction Work was begun on 1952; was completed on 1952
(Date) (Date)

and the ground water claimed was first used for the purposes set out below on 1952
(Date)
since which time the water has been used continuously
(Continuously or intermittently)
from 1952 to present time
(Date) (Date)

4. Quantity of water claimed and used is 200 gallons per minute; 112.25 acre feet per year.

5. Purpose or Purposes for which water is used Irrigation
(Domestic, irrigation, municipal, manufacturing, industrial, etc.)

6. Description of Well: Depth 29 feet. Type Drilled
(Dug or drilled)
diameter 8 inches. Elevation of ground at well site 325 feet, mean sea level.
(As near as known)
Depth to water table 12 feet.

7. Capacity of Well: 400 g.p.m. with 4 feet drawdown.
_____ g.p.m. with _____ feet drawdown.

Date of test 1952

If Flowing Well: Measured discharge _____ g.p.m. on _____
(Date)

Shut-in pressure at ground surface _____ lbs. per sq. in. on _____
(Date)

Water is controlled by _____
(Cap, valve, etc.)

8. Casing: (Give diameter, commercial specifications and depth below ground surface of each casing size.)

8 inch diameter steel casing from 0 to 29 feet
_____ inch diameter _____ from _____ to _____ feet
_____ inch diameter _____ from _____ to _____ feet
_____ inch diameter _____ from _____ to _____ feet

Describe and show depth of shoe, plug, adapter, liner or other details: _____

9. Perforated Casings or Screens:

Slot perforations from 22 to 29
(Number per foot and size of perforations, or describe screen)
_____ from _____ to _____
_____ from _____ to _____
_____ from _____ to _____

10. Log of Well: (Describe each stratum or formation clearly, indicate if water bearing, and give thickness and depth as indicated.)

MATERIAL	Thickness (Feet)	Depth to Bottom (Feet)
Not available		

If log of well is not available, give name and address of driller. Marion West, Salem, Oregon

11. Infiltration Trench: Covered or open _____

Dimensions: Length _____ ft. Minimum depth _____ ft. Maximum depth _____ ft.
Bottom width _____ ft. Discharge _____ g.p.m. Date of test _____

12. Tunnel: Type of lining _____

Dimensions: _____
(Length, course, and cross sectional size)
Position of water bearing stratum with reference to portal of tunnel _____

Log of tunnel: (Preceding table for log of well may be used, if desired. Give footage from portal and character of materials, as pertinent.)

13. Pumping Equipment:


(a) Pump 3" centrifugal Capacity 300 g.p.m.
(Make, type and size)
(b) Motor 15 H. P. electric
(Type and horsepower)

14. Location of area irrigated or to be irrigated, or place of use if for purposes other than irrigation.

Township North or South	Range E. or W. of Willamette Meridian	Section	Forty-acre Tract	Number Acres To Be Irrigated	Date of Reclamation
11 S	2 W	35	SE $\frac{1}{4}$ of SW $\frac{1}{4}$	28.4	1952
11 S	2 W	35	NE $\frac{1}{4}$ of SW $\frac{1}{4}$	2.3	"
11 S	2 W	35	NW $\frac{1}{4}$ of SW $\frac{1}{4}$	0.1	"
11 S	2 W	35	SW $\frac{1}{4}$ of SW $\frac{1}{4}$	1.2	"
12 S 11 S	2 W	2	NW $\frac{1}{4}$ of NW $\frac{1}{4}$	0.5	"
12 S 11 S	2 W	2	NE $\frac{1}{4}$ of NW $\frac{1}{4}$	12.4	"
				44.9	

15. If the ground water supply is supplemental to an existing water supply, identification of any application for a permit, permit, certificate or adjudicated right to appropriate water made or held by the registrant.

Township 11 S Range 2 W W.M.
North

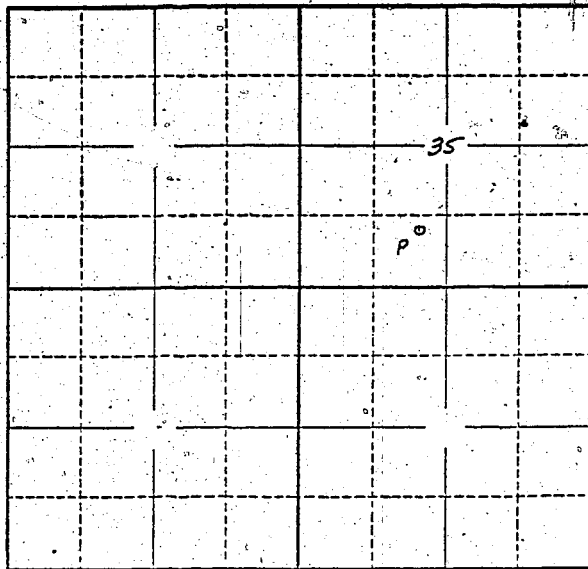

Locate well and acreage of irrigated land on plat.
Scale: 2" = 1 Mile

STATE OF OREGON }
County of LINN } ss.

I, Sylva Carter, being first duly sworn, do hereby certify that I have read the foregoing Registration Statement and that all of the items therein contained are true to the best of my knowledge and belief.

Sylva Carter
(Signature of Registrant)

Subscribed and sworn to before me this 1st day of July, 1958

My commission expires MY COMMISSION EXPIRES MARCH 12, 1959
Stanh McNeil
(Notary Public)

(SEAL)

CERTIFICATE OF REGISTRATION

STATE OF OREGON }
County of Marion } ss.

This is to certify that the foregoing Registration Statement was received in the office of the State Engineer on the 7th day of July, 1958, at 8:00 o'clock A.M. and has been duly recorded in said office in Book No. 8 of Registration Statements on page GR-1856

Witness my hand this 26th day of January, 1959

Ruth A. Stanley
(State Engineer)

By _____
(Deputy)

1725