

Registration Statement

OF CLAIMANT OF RIGHT TO APPROPRIATE GROUND WATER

TO THE STATE ENGINEER OF OREGON:

I, Ivan and Edna M. Frazier

of Route 1, Brownsville

(Mailing address)

County of Linn

State of Oregon

do hereby make application for a certificate of registration as evidence of a right to appropriate ground water.

1. Source from which water is withdrawn is pump well

(Flowing well, pump well, infiltration trench, or tunnel)

2. Location is: 3/4 mile south of Brownsville, Oregon

(Approximate distance and direction from nearest city or town)

and is more particularly described as follows:

(a) N. 63° 30' E. 40.75 chains from SW corner of D1C 37, T. 14 S, R. 3 W.

(Give distance and bearing to corner of section or other legal subdivision)

being within SW 1/4 of SW 1/4

(Smallest legal subdivision)

of Sec. 6

Twp. 14 S

(N. or S.)

Rge. 2 W

(E. or W.)

or (b) within limits of recorded platted property, town or city:

in Lot _____, Block _____ of _____

(Name of plat or addition)

County of Linn

(If within city or town, give name)

3. Construction Work was begun on Aug. 1, 1950

(Date)

; was completed on Aug. 7, 1950

(Date)

and the ground water claimed was first used for the purposes set out below on Aug. 10, 1950

(Date)

since which time the water has been used continuously

(Continuously or intermittently)

from Aug. 10, 1950 to present time

(Date)

(Date)

4. Quantity of water claimed and used is 100 gallons per minute; 15.0 acre feet per year.

5. Purpose or Purposes for which water is used Irrigation

(Domestic, irrigation, municipal, manufacturing, industrial, etc.)

6. Description of Well: Depth 58 feet. Type Drilled

(Dug or drilled)

diameter 8 inches. Elevation of ground at well site 325 feet, mean sea level.

(As near as known)

Depth to water table 22 feet.

7. Capacity of Well: 100 g.p.m. with 2 feet drawdown.

_____ g.p.m. with _____ feet drawdown.

Date of test Estimated - not tested

If Flowing Well: Measured discharge _____ g.p.m. on _____

(Date)

Shut-in pressure at ground surface _____ lbs. per sq. in. on _____

(Date)

Water is controlled by _____

(Cap, valve, etc.)

11. Infiltration Trench: Covered or open

Dimensions: Length ft. Minimum depth ft. Maximum depth ft.
 Bottom width ft. Discharge g.p.m. Date of test

12. Tunnel: Type of lining

Dimensions:
 (Length, course, and cross sectional size)
 Position of water bearing stratum with reference to portal of tunnel

Log of tunnel: (Preceding table for log of well may be used, if desired. Give footage from portal and character of materials, as pertinent.)

13. Pumping Equipment:

(a) Pump Peerless Champion Model 3C9 Capacity 100 g.p.m.
 (Make, type and size)
 (b) Motor 3 H. P. Electric
 (Type and horsepower)


14. Location of area irrigated or to be irrigated, or place of use if for purposes other than irrigation.

Township North or South	Range E. or W. of Willamette Meridian	Section	Forty-acre Tract	Number Acres To Be Irrigated	Date of Reclamation
14 S	2 W	6	NW 1/4 of SW 1/4	0.5	Aug. 10, 1950
14 S	2 W	6	SW 1/4 of SW 1/4	2.2	" "
14 S	3 W	1	NE 1/4 of SE 1/4	0.6	" "
14 S	3 W	1	SE 1/4 of SE 1/4	2.7	" "
				6.0	

Beginning on the west boundary of the Donation Land Claim of Alexander Kirk and wife, Not. No. 2136, Claim No. 37, in Township 14, South of Range 3 West of the Willamette Meridian, Oregon, at a point thereon 11.50 chains North of the Southwest corner of said claim, and running from thence East parallel with the South boundary of said claim 40.00 chains to the East boundary of said Donation Land Claim; thence North along the East boundary of said Donation Land Claim 6.75 chains; thence West parallel with the South boundary of said claim 40.00 chains to the West boundary of said claim, and thence South 6.75 chains to the place of beginning, containing 27 acres, more or less in Linn County, Oregon.

15. If the ground water supply is supplemental to an existing water supply, identification of any application for a permit, permit, certificate or adjudicated right to appropriate water made or held by the registrant.

Township 14 S Range 2 E W.M.
North

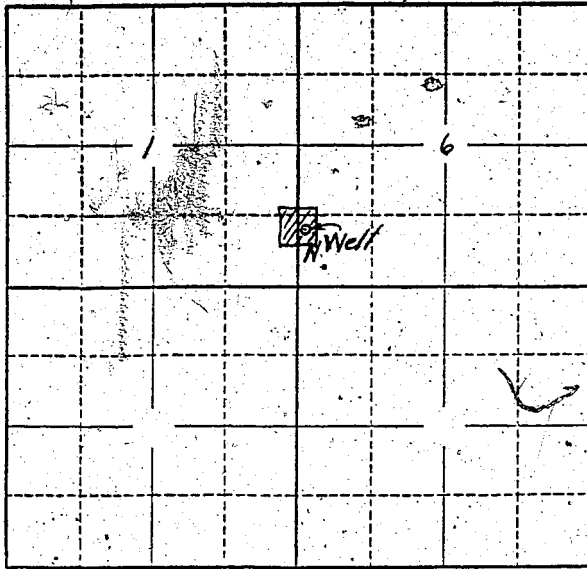

Locate well and acreage of irrigated land on plat.
Scale: 2" = 1 Mile

STATE OF OREGON }
County of LINN } ss.

I, Ivan and Edna M. Frazier, being first duly sworn, do hereby certify that I have read the foregoing Registration Statement and that all of the items therein contained are true to the best of my knowledge and belief.

Ivan Frazier
Edna M. Frazier
(Signature of Registrant)

Subscribed and sworn to before me this _____ day of _____, 19____.

My commission expires Sept 2 1962 _____
(Notary Public)

(SEAL)

CERTIFICATE OF REGISTRATION

STATE OF OREGON }
County of Marion } ss.

This is to certify that the foregoing Registration Statement was received in the office of the State Engineer on the 7th day of July, 1958, at 8:00 o'clock A. M. and has been duly recorded in said office in Book No. 8 of Registration Statements on page GR-1857.

Witness my hand this 26th day of January, 1959.

Lawrence A. Cottamley
(State Engineer)

4.500

By _____
(Deputy)

GR-1857