

Registration Statement

OF CLAIMANT OF RIGHT TO APPROPRIATE GROUND WATER

(Under Chapter 708, Oregon Laws 1955.)

TO THE STATE ENGINEER OF OREGON:

I, H. J. Rehfuess 4340 Cherry Ave
of Salem County of Marion

State of Oregon do hereby make application for a certificate of registration as evidence of a right to appropriate ground water.

1. Source from which water is withdrawn is Pump Well
(Flowing well, pump well, infiltration trench, or tunnel)

2. Location is: 4 miles North of Salem
(Approximate distance and direction from nearest city or town)

and is more particularly described as follows: 1125 feet North & 400 feet west from S 1/4 corner

(a) as shown on attached diagram
(Give distance and bearing to corner of section or other legal subdivision)
being within SE 1/4 of SW 1/4 of Sec. 2, Twp. 7S, Rge. 3W
(Smallest legal subdivision) (N. or S.) (E. or W.)

or (b) within limits of recorded platted property, town or city:

in Lot _____, Block _____ of _____
(Name of plat or addition)

County of _____
(If within city or town, give name)

3. Construction Work was begun on MAY 18/53; was completed on MAY 19/53
(Date) (Date)

and the ground water claimed was first used for the purposes set out below on JUNE 1/53
(Date)

since which time the water has been used intermittently
(Continuously or Intermittently)

from JUNE 1/53 to Sept 30/58
(Date) (Date)

4. Quantity of water claimed and used is 165 gallons per minute; _____ acre feet per year.

5. Purpose or Purposes for which water is used Irrigation

(Domestic, irrigation, municipal, manufacturing, industrial, etc.)

6. Description of Well: Depth 31 feet. Type Drilled
(Dug or drilled)

diameter 8 inches. Elevation of ground at well site 170 feet, mean sea level.
(As near as known)

Depth to water table 18 feet.

7. Capacity of Well: 1000 g.p.m. with 7 feet drawdown.

_____ g.p.m. with _____ feet drawdown.


Date of test JUNE/53

If Flowing Well: Measured discharge _____ g.p.m. on _____
(Date)

Shut-in pressure at ground surface _____ lbs. per sq. in. on _____
(Date)

Water is controlled by _____
(Cap, valve, etc.)

Township 7S Range 3W W.M.
North

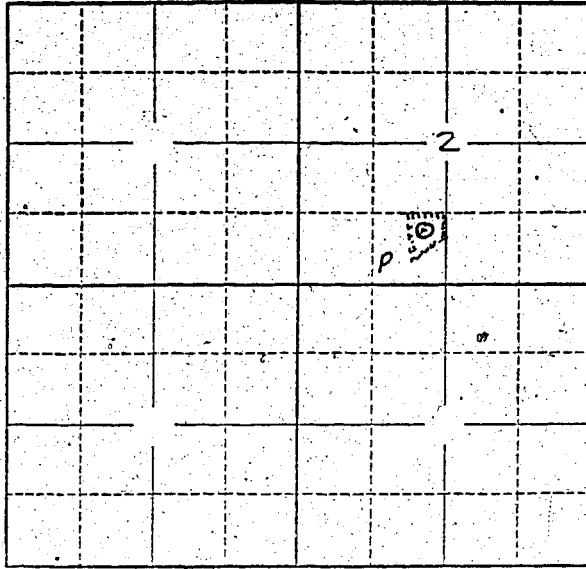

Locate well and acreage of irrigated land on plat.
Scale: 2" = 1 Mile

STATE OF OREGON }
County of Marion } ss.

I, Herman J. Rehluss, being first duly sworn, do hereby certify that I have read the foregoing Registration Statement and that all of the items therein contained are true to the best of my knowledge and belief.

Herman J. Rehluss
(Signature of Registrant)

Subscribed and sworn to before me this 1st day of July, 1959.

My commission expires _____
(Notary Public)

(SEAL)

Henry C. Mattson
My Comm. Exp. 7.8.16
1962 WSB

CERTIFICATE OF REGISTRATION

STATE OF OREGON }
County of Marion } ss.

This is to certify that the foregoing Registration Statement was received in the office of the State Engineer on the 7th day of July, 1959, at 1.00 o'clock P.M. and has been duly recorded in said office in Book No. 8 of Registration Statements on page GR-1860

Witness my hand this 25th day of January, 1959.

Lewis A. Stanley
(State Engineer)

By _____ (Deputy)

GR-1860

#1500