

Registration Statement CERTIFICATE NO. GR-1861

OF CLAIMANT OF RIGHT TO APPROPRIATE GROUND WATER

(Under Chapter 708, Oregon Laws 1955.)

TO THE STATE ENGINEER OF OREGON:

I, SCHINDLER BROS  
of RIEL DAYTON County of YAMHILL  
State of OREGON, do hereby make application for a certificate of registration as evidence  
of a right to appropriate ground water.

- 1. Source from which water is withdrawn is Pumpwell  
(Flowing well, pump well, infiltration trench, or tunnel)
- 2. Location is: 7 miles South of Dayton  
(Approximate distance and direction from nearest city or town)

and is more particularly described as follows:

- (a) 7.54 ft North of iron pipe on SW corner Sec 14  
(Give distance and bearing to corner of section or other legal subdivision)
- being within SW 1/4 SW 1/4 of Sec. 14, Twp. 55, Rge. 3W  
(Smallest legal subdivision) (N. or S.) (E. or W.)
- or (b) within limits of recorded platted property, town or city:
- in Lot \_\_\_\_\_, Block \_\_\_\_\_ of \_\_\_\_\_  
(Name of plat or addition)

County of \_\_\_\_\_  
(If within city or town, give name)

- 3. Construction Work was begun on not known Prior to 1952; was completed on not known Prior to 1952  
(Date) (Date)

and the ground water claimed was first used for the purposes set out below on 1952  
(Date)  
since which time the water has been used Continuously  
(Continuously or intermittently)  
from May to September  
(Date) (Date)

4. Quantity of water claimed and used is 150 gallons per minute; \_\_\_\_\_ acre  
feet per year.

5. Purpose or Purposes for which water is used Irrigation

(Domestic, irrigation, municipal, manufacturing, industrial, etc.)

6. Description of Well: Depth 70 feet. Type Drilled  
(Dug or drilled)  
diameter 12 inches. Elevation of ground at well site 110 feet, mean sea level.  
(As near as known)  
Depth to water table 32 feet.

7. Capacity of Well: not known g.p.m. with \_\_\_\_\_ feet drawdown.  
\_\_\_\_\_ g.p.m. with \_\_\_\_\_ feet drawdown.

Date of test not tested

If Flowing Well: Measured discharge \_\_\_\_\_ g.p.m. on \_\_\_\_\_  
(Date)


Shut-in pressure at ground surface \_\_\_\_\_ lbs. per sq. in. on \_\_\_\_\_  
(Date)

Water is controlled by \_\_\_\_\_  
(Cap, valve, etc.)





Township 55 Range 3W W.M.  
North

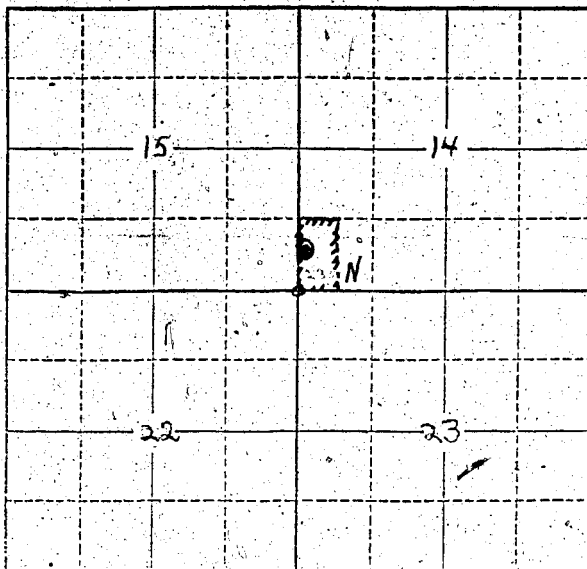

Locate well and acreage of irrigated land on plat.  
Scale: 2" = 1 Mile

STATE OF OREGON

County of Marion } ss.

I, Albert Schendler, being first duly sworn, do hereby certify that I have read the foregoing Registration Statement and that all of the items therein contained are true to the best of my knowledge and belief.

Albert Schendler  
(Signature of Registrant)

Subscribed and sworn to before me this 7th day of July, 1958.

My commission expires September 8, 1960 Max Rogers  
(Notary Public)

(SEAL)

CERTIFICATE OF REGISTRATION

STATE OF OREGON

County of Marion } ss.

This is to certify that the foregoing Registration Statement was received in the office of the State Engineer on the 7th day of July, 1958, at 1:30 o'clock P. M. and has been duly recorded in said office in Book No. 8 of Registration Statements on page GR-1861

~~Construction shall be completed by 1959 and the water completely applied to the land by 1960.~~

Witness my hand this 26th day of January, 1959

Laura A. Stanton  
(State Engineer)

By \_\_\_\_\_ (Deputy)

GR-1861

\$15.00