

RECEIVED
JUN 30 1958

STATE ENGINEER
SALEM, OREGON

Registration No. GR GR-1941

Certificate No. GR 2-1872

Registration Statement

OF CLAIMANT OF RIGHT TO APPROPRIATE GROUND WATER

TO THE STATE ENGINEER OF OREGON:

BLUE LAKE PARK WELL NO. I

I, H. B. Welsh

of Blue Lake Park, Fairview County of Multnomah
(Mailing address)
State of Oregon

do hereby make application for a certificate of registration as evidence of a right to appropriate ground water.

1. Source from which water is withdrawn is pump well #1
(Flowing well, pump well, infiltration trench, or tunnel)

2. Location is: 1 1/2 mi NW of Fairview, Oregon
(Approximate distance and direction from nearest city or town)

and is more particularly described as follows:

(a) 1200 feet south and 400 feet east of the NW corner of the John Crosby Donation land claim (Give distance and bearing to corner of section or other legal subdivision)
(Smallest legal subdivision) (N. or S.) (E. or W.)

or (b) within limits of recorded/platted property, town or city:

in Lot _____, Block _____ of _____
(Name of plat or addition)
County of Multnomah County
(If within city or town, give name)

3. Construction Work was begun on _____; was completed on 1940 approximately
(Date) (Date)

and the ground water claimed was first used for the purposes set out below on 1940
(Date)

since which time the water has been used continuously
(Continuously or intermittently)

from 1940 to Oct 1957
(Date) (Date)

4. Quantity of water claimed and used is 200 gallons per minute; _____ acre feet per year.

5. Purpose or Purposes for which water is used drinking and irrigation of lawns, serves water for park patrons, toilets showers, etc., plus 5 homes
(Domestic, irrigation, municipal, manufacturing, industrial, etc.)

6. Description of Well: Depth 67 1/2 feet. Type drilled
(Dug or drilled)
diameter 8 inches. Elevation of ground at well site 22.5 feet, mean sea level.
(As near as known)

Depth to water table 11 feet. This well is in constant use and at the last test, drew down about 3 feet and came

7. Capacity of Well: 350 g.p.m. with 5 feet drawdown. back to about 3 feet below regular level.
_____ g.p.m. with _____ feet drawdown.

Date of test August 1946

If Flowing Well: Measured discharge _____ g.p.m. on _____
(Date)

Shut-in pressure at ground surface _____ lbs. per sq. in. on _____
(Date)

Water is controlled by _____
(Cap, valve, etc.)

8. Casing: (Type diameter, commercial specifications and depth below ground surface of each casing size.)

8 inch diameter from to bottom feet
..... inch diameter from to feet
..... inch diameter from to feet
..... inch diameter from to feet

Describe and show depth of shoe, plug, adapter, liner or other details:

.....
.....

9. Perforated Casings or Screens:

well was perforated after drilling from to
(Number per foot and size of perforations, or describe screen)
..... from to
..... from to
..... from to

10. Log of Well: (Describe each stratum or formation clearly, indicate if water bearing, and give thickness and depth as indicated.)

MATERIAL	Thickness (Feet)	Depth to Bottom (Feet)
I do not have a well log. Mr Al Ziesing, the driller has since passed on and I do not have this data.		

If log of well is not available, give name and address of driller.

Mr. A.L. Ziesing

9900 S E 82nd Avenue, Portland, Oregon

11. Infiltration Trench: Covered or open

Dimensions: Length _____ ft. Minimum depth _____ ft. Maximum depth _____ ft.

Bottom width _____ ft. Discharge _____ g.p.m. Date of test _____

12. Tunnel: Type of lining

Dimensions: _____
(Length, course, and cross sectional size)

Position of water bearing stratum with reference to portal of tunnel _____

Log of tunnel: (Preceding table for log of well may be used, if desired. Give footage from portal and character of materials, as pertinent.)

13. Pumping Equipment:

(a) Pump 7 1/2 HP turbine Deming Capacity 175 g.p.m.
(Make, type and size)

(b) Motor 7 1/2 HP U.S. Motors Los Angeles, Cal.
(Type and horsepower)


14. Location of area irrigated or to be irrigated, or place of use if for purposes other than irrigation.

Township North or South	Range E. or W. of Willamette Meridian	Section	Forty-acre Tract	Number Acres To Be Irrigated	Date of Reclamation
1 N	3 E	21	55-82 acres	<u>20.0</u> Total	1940
"	"	"	SE 1/4 of NW 1/4	<u>12.0</u>	"
"	"	"	NE 1/4 of SW 1/4	<u>8.0</u> 20.0 Ac.	"

15. If the ground water supply is supplemental to an existing water supply, identification of any application for a permit, permit, certificate or adjudicated right to appropriate water made or held by the registrant.

Blue Lake in Sec. 20 & 21 1N 3E

Township 1N Range 3E, W.M.
North

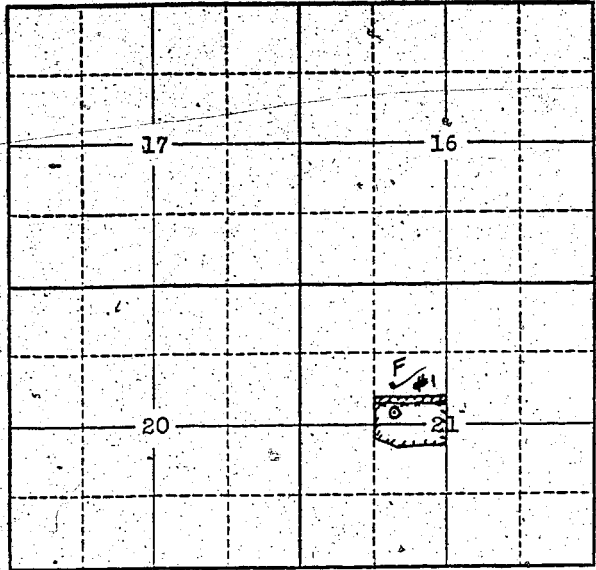

Locate well and acreage of irrigated land on plat.
Scale: 2" = 1 Mile

STATE OF OREGON }
County of MULTNOMAH } ss.

I, N. B. WELSH, being first duly sworn, do hereby certify that I have read the foregoing Registration Statement and that all of the items therein contained are true to the best of my knowledge and belief.

N. B. Welsh
(Signature of Registrant)

Subscribed and sworn to before me this 27TH day of JUNE, 19 58.

My commission expires AUGUST 20, 1959
(Notary Public)

(SEAL)

CERTIFICATE OF REGISTRATION

STATE OF OREGON }
County of Marion } ss.

This is to certify that the foregoing Registration Statement was received in the office of the State Engineer on the 8th day of July, 19 58, at 8:00 o'clock A. M. and has been duly recorded in said office in Book No. 8 of Registration Statements on page GR-1872.

Witness my hand this 26th day of January, 19 59

Lewis A. Stanley
(State Engineer)

By _____
(Deputy)

\$ 25.00

GR-1872