

RECEIVED
JUN 30 1958

STATE ENGINEER
SALEM, OREGON

Registration Statement

1942
Registration No. GR. - [redacted]

Certificate No. GR. - 1873

OF CLAIMANT OF RIGHT TO APPROPRIATE GROUND WATER

TO THE STATE ENGINEER OF OREGON:

BLUE LAKE PARK WELL NO. 2

I, N.B. Welsh

of Blue Lake Park, Fairview, Oregon County of Multnomah
(Mailing address)

State of Oregon, do hereby make application for a certificate of registration as evidence of a right to appropriate ground water:

- 1. Source from which water is withdrawn is pump well #2
(Flowing well, pump well, infiltration trench, or tunnel)
- 2. Location is: 1 1/2 miles NW of Fairview, Oregon
(Approximate distance and direction from nearest city or town)

and is more particularly described as follows: 1600 hundred feet south and 400 feet east

(a) of the N.W. corner of the John O'Connell donation land claim
(Give distance and bearing to corner of section or other legal subdivision)

being within NE 1/4 of SW 1/4 of Sec. 21, Twp. 1 N, Rge. 5 E
(Smallest legal subdivision) (N. or S.) (E. or W.)

or (b) within limits of recorded platted property, town or city:

in Lot _____, Block _____ of _____
(Name of plat or addition)

County of Multnomah
(If within city or town, give name)

- 3. Construction Work was begun on _____; was completed on 1948
(Date) (Date)

and the ground water claimed was first used for the purposes set out below on _____
(Date)

since which time the water has been used each summer July through September
(Continuously or intermittently)

from July 1st to Sept 1st
(Date) (Date)

- 4. Quantity of water claimed and used is 300 gallons per minute; _____ acre feet per year.

- 5. Purpose or Purposes for which water is used used in keeping the water clear in swimming area of lake and also in operation of chlorinator.
(Domestic, irrigation, municipal, manufacturing, industrial, etc.)

- 6. Description of Well: Depth 101 1/2 feet. Type drilled
(Bog or drilled)

diameter 8 inches. Elevation of ground at well site 112 feet, mean sea level.
(As near as known)

Depth to water table 1 to 2 feet. flows part of the time into lake

- 7. Capacity of Well: 350 g.p.m. with 60 feet drawdown.

200 g.p.m. with 20 feet drawdown.

These figures are approximate at this time. Inspection has been made since the well was drilled and the pump installed in 1948

Date of test _____

If Flowing Well: Measured discharge _____ g.p.m. on _____
(Date)

Shut-in pressure at ground surface _____ lbs. per sq. in. on _____
(Date)

Water is controlled by _____
(Cap, valve, etc.)

8. Casing: (Give diameter, commercial specifications and depth below ground surface of each casing size.)

8 inch diameter from to ^{101 1/2} feet
 bottom feet
 inch diameter 0 from to feet
 inch diameter from to feet
 inch diameter from to feet

Describe and show depth of shoe, plug, adapter, liner or other details:

.....

9. Perforated Casings or Screens:

perforated

(Number per foot and size of perforations, or describe screen)

from to

from to

from to

from to

10. Log of Well: (Describe each stratum or formation clearly, indicate if water bearing, and give thickness and depth as indicated.)

MATERIAL	Thickness (Feet)	Depth to Bottom (Feet)
There is no log available to me at this time.		
MR. A.L. Wessing, the man who drilled the well has since passed away. I remember only that in drilling he had to go through a good many feet of what he called a concrete gravel bar- I think 70 or 80 feet of it.		

If log of well is not available, give name and address of driller Mr. A.L. Ziesler
9900 S E 82nd Ave. Portland, Oregon

11. Infiltration Trench: Covered or open _____
 Dimensions: Length _____ ft. Minimum depth _____ ft. Maximum depth _____ ft.
 Bottom width _____ ft. Discharge _____ g.p.m. Date of test _____

12. Tunnel: Type of lining _____
 Dimensions: _____
(Length, course, and cross sectional size)
 Position of water bearing stratum with reference to portal of tunnel _____

Log of tunnel: (Preceding table for log of well may be used, if desired. Give footage from portal and character of materials, as pertinent.)


13. Pumping Equipment:
 (a) Pump Deming turbine Capacity 375 g.p.m.
(Make, type and size)
 (b) Motor U.S. Motor 15 H P
(Type and horsepower)

14. Location of area irrigated or to be irrigated, or place of use if for purposes other than irrigation.

Township North or South	Range E. or W. of Willamette Meridian	Section	Forty-acre Tract	Number Acres To Be Irrigated	Date of Reclamation
1 N	3 E	20 & 21	Blue Lake		
The water from this well is hooked to the main line of the Park so that in case of trouble with the regular Park well or pump this one could be used simply by turning the one off and the other one on. Otherwise the water from this pump is being circulated throughout the swimming area directly into the lake.					
1 N	3 E	21	SE 1/4 of NW 1/4	12 ^e	1945
"	"	"	NE 1/4 of SW 1/4	8 ^e	"
				20 ^e	"

15. If the ground water supply is supplemental to an existing water supply, identification of any application for a permit, permit, certificate or adjudicated right to appropriate water made or held by the registrant.

Township 11N Range 3E W.M.
North

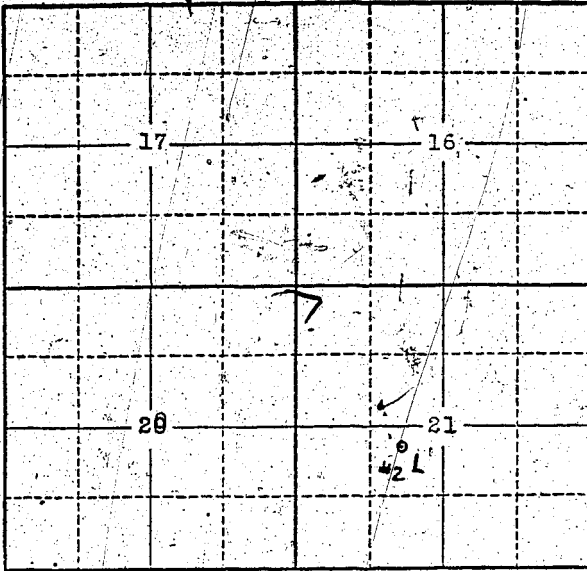

Locate well and acreage of irrigated land on plat.
Scale: 2" = 1 Mile

STATE OF OREGON

County of MULTNOMAH } ss.

I, N. B. WELSH, being first duly sworn, do hereby certify that I have read the foregoing Registration Statement and that all of the items therein contained are true to the best of my knowledge and belief.

N. B. Welsh
(Signature of Registrant)

Subscribed and sworn to before me this 27TH day of JUNE, 19 58.

My commission expires AUGUST 20, 1959
(Notary Public)

(SEAL)

CERTIFICATE OF REGISTRATION

STATE OF OREGON

County of Marion } ss.

This is to certify that the foregoing Registration Statement was received in the office of the State Engineer on the 8th day of July, 19 58, at 8⁰⁰ o'clock A.M. and has been duly recorded in said office in Book No. 88 of Registration Statements on page GR-1873

Witness my hand this 26th day of January, 19 59.

Lewis A. Stanley
(State Engineer)

\$25.00

By _____ (Deputy)

GR-1873