

RECEIVED
JUL 2 1958

STATE ENGINEER
SALEM, OREGON

Registration No. GR 1943

Certificate No. GR 1869

Registration Statement

OF CLAIMANT OF RIGHT TO APPROPRIATE GROUND WATER

TO THE STATE ENGINEER OF OREGON:

I, Gilbert W Ringerling

of Route 1 Box 275 B Scappoose County of Columbia
(Mailing address)

State of Oregon, do hereby make application for a certificate of registration as evidence of a right to appropriate ground water.

1. Source from which water is withdrawn is pump well
(Flowing well, pump well, infiltration trench, or tunnel)

2. Location is: 2 Mi North of Scappoose
(Approximate distance and direction from nearest city or town)

and is more particularly described as follows: 1020 feet south & 160 feet east from N 1/4 corner Sect. 6.

(a) 2 mi North of NE corner of Sect 6
NW 1/4 of NE 1/4 Give distance and bearing to corner of section or other legal subdivision

being within lot 3, 2 ac. in McPherson D.L.C. of Sec 6, Twp. 3 N, Rge. 1 W
(Smallest legal subdivision) (N. or S.) (E. or W.)

or (b) within limits of recorded platted property, town or city:

in Lot _____, Block _____ of _____
(Name of plat or addition)

County of _____
(If within city or town, give name)

3. Construction Work was begun on unk; was completed on 1952
(Date) (Date)

and the ground water claimed was first used for the purposes set out below on 1952
(Date)

since which time the water has been used continuously during season
(Continuously or intermittently)

from 1952 to date
(Date) (Date)

4. Quantity of water claimed and used is 7 259 gallons per minute; 1 135 acre feet per year.

5. Purpose or Purposes for which water is used domestic and irrigation

(Domestic, irrigation, municipal, manufacturing, industrial, etc.)

6. Description of Well: Depth 150 feet. Type driller
(Dug or drilled)

diameter 10 inches. Elevation of ground at well site 30 feet, mean sea level.
(As near as known)

Depth to water table 120 feet.

7. Capacity of Well: _____ g.p.m. with _____ feet drawdown.

_____ g.p.m. with _____ feet drawdown.

Date of test _____

If Flowing Well: Measured discharge _____ g.p.m. on _____
(Date)

Shut-in pressure at ground surface _____ lbs. per sq. in. on _____
(Date)

Water is controlled by _____
(Cap, valve, etc.)

8. **Casing:** (Give diameter, commercial specifications and depth below ground surface of each casing size.)

10 inch diameter from to feet
 inch diameter from to feet
 inch diameter from to feet
 inch diameter from to feet

Describe and show depth of shoe, plug, adapter, liner or other details:

9. **Perforated Casings or Screens:**

(Number per foot and size of perforations, or describe screen)

..... from to
 from to
 from to
 from to

10. **Log of Well:** (Describe each stratum or formation clearly, indicate if water bearing, and give thickness and depth as indicated.)

MATERIAL	Thickness (Feet)	Depth to Bottom (Feet)

If log of well is not available, give name and address of driller.
 not known to applicant

11. Infiltration Trench: Covered or open covered

Dimensions: Length ft. Minimum depth ft. Maximum depth ft.
 Bottom width ft. Discharge g.p.m. Date of test

12. Tunnel: Type of lining

Dimensions:
 (Length, course, and cross sectional size)

Position of water bearing stratum with reference to portal of tunnel

Log of tunnel: (Preceding table for log of well may be used, if desired. Give footage from portal and character of materials, as pertinent.)

13. Pumping Equipment:

(a) Pump 2 1/2 Centrifugal Capacity 260 g.p.m.
 (Make, type and size)

(b) Motor 10 H P
 (Type and horsepower)


14. Location of area irrigated or to be irrigated, or place of use if for purposes other than irrigation.

Township North or South	Range E. or W. of Williams Meridian	Section	Forty-acre Tract	Number Acres To Be Irrigated	Date of Reclamation
3N	1W	6	NW 1/4	22	1952
4N	1W	31	SW 1/4	33 145 acres	"
3N	1W	6	NW 1/4 of NE 1/4	10 ⁰	1952
"	"	6	SW 1/4 of NE 1/4	3 ⁰	"
"	"	6	NE 1/4 of NW 1/4	8 ⁰	"
"	"	6	SE 1/4 of NW 1/4	22 ⁰	"
4N	1W	31	SW 1/4 of SE 1/4	2 ⁰	"
				<u>45⁰ Total</u>	"

15. If the ground water supply is supplemental to an existing water supply, identification of any application for a permit, permit, certificate or adjudicated right to appropriate water made or held by the registrant.

Township 317N Range 1W, W.M.

North

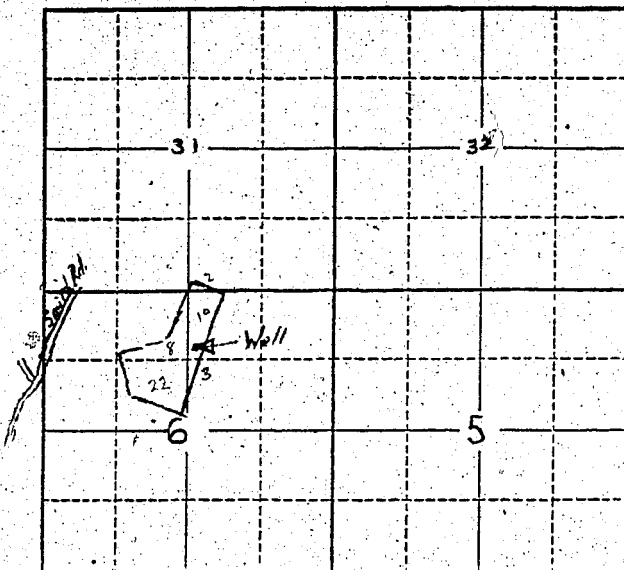

Locate well and acreage of irrigated land on plat.

Scale: 2" = 1 Mile

STATE OF OREGON

County of Columbia } ss.

I, Gilbert St. Ringering, being first duly sworn, do hereby certify that I have read the foregoing Registration Statement and that all of the items therein contained are true to the best of my knowledge and belief.

Gilbert St. Ringering
(Signature of Registrant)

Subscribed and sworn to before me this 1 day of July, 1958.

My commission expires Nov. 4, 1960 Marie Stalder
(Notary Public)

(SEAL)

CERTIFICATE OF REGISTRATION

STATE OF OREGON }
County of Marion } ss.

This is to certify that the foregoing Registration Statement was received in the office of the State Engineer on the 8th day of July, 1958, at 8:00 o'clock A.M. and has been duly recorded in said office in Book No. 8 of Registration Statements on page GR-1869

Witness my hand this 26th day of January, 1959

Lewis A. Stanley
(State Engineer)

By _____
(Deputy)

#1725

GR - 1869