

**Registration Statement****OF CLAIMANT OF RIGHT TO APPROPRIATE GROUND WATER**

(Under Chapter 708, Oregon Laws 1955.)

**TO THE STATE ENGINEER OF OREGON:**I, Donald A. Bellof Rt. 2, Box 116, Scio County of LinnState of Oregon, do hereby make application for a certificate of registration as evidence of a right to appropriate ground water.1. Source from which water is withdrawn is pump well  
(Flowing well, pump well, infiltration trench, or tunnel)2. Location is: 1 mile west of Scio, Oregon  
(Approximate distance and direction from nearest city or town)

and is more particularly described as follows:

(a) S. 78° E. 9.0 chains from the NW corner of the NE $\frac{1}{4}$  of S. 15, T. 10 S., R. 2 W.W.M.  
(Give distance and bearing to corner of section or other legal subdivision)being within NW $\frac{1}{4}$  of NE $\frac{1}{4}$  of Sec. 15, Twp. 10 S, Rge. 2 W.  
(Smallest legal subdivision) (N. or S.) (E. or W.)

or (b) within limits of recorded platted property, town or city:

in Lot \_\_\_\_\_, Block \_\_\_\_\_ of \_\_\_\_\_  
(Name of plat or addition)County of Linn

(If within city or town, give name)

3. Construction Work was begun on July 6, 1953; was completed on July 12, 1953  
(Date) (Date)and the ground water claimed was first used for the purposes set out below on July 15, 1953  
(Date)since which time the water has been used continuously  
(Continuously or intermittently)from July 15, 1953 to present time  
(Date) (Date)4. Quantity of water claimed and used is 240 gallons per minute; 60 acre feet per year.5. Purpose or Purposes for which water is used Irrigation

(Domestic, irrigation, municipal, manufacturing, industrial, etc.)

6. Description of Well: Depth 71 feet. Type drilled  
(Dug or drilled)  
diameter 8 inches. Elevation of ground at well site 290 feet, mean sea level.  
(As near as known)  
Depth to water table 15 feet.7. Capacity of Well: 250 g.p.m. with 35 feet drawdown.  
\_\_\_\_\_ g.p.m. with \_\_\_\_\_ feet drawdown.Date of test July 15, 1953If Flowing Well: Measured discharge \_\_\_\_\_ g.p.m. on \_\_\_\_\_  
(Date)Shut-in pressure at ground surface \_\_\_\_\_ lbs. per sq. in. on \_\_\_\_\_  
(Date)Water is controlled by \_\_\_\_\_  
(Cap, valve, etc.)



If log of well is not available, give name and address of driller. Wm. Long, Rt. 3, Scio, Oregon

11. Infiltration Trench: Covered or open

Dimensions: Length \_\_\_\_\_ ft. Minimum depth \_\_\_\_\_ ft. Maximum depth \_\_\_\_\_ ft.

Bottom width \_\_\_\_\_ ft. Discharge \_\_\_\_\_ g.p.m. Date of test \_\_\_\_\_

12. Tunnel: Type of lining

Dimensions: \_\_\_\_\_  
(Length, course, and cross sectional size)

Position of water bearing stratum with reference to portal of tunnel \_\_\_\_\_

Log of tunnel: (Preceding table for log of well may be used, if desired. Give footage from portal and character of materials, as pertinent.)

13. Pumping Equipment:

(a) Pump Berkeley turbine Capacity 250 g.p.m.  
(Make, type and size)

(b) Motor 7 1/2 H.P. electric motor  
(Type and horsepower)


14. Location of area irrigated or to be irrigated, or place of use if for purposes other than irrigation.

Township North or South	Range E. or W. of Willamette Meridian	Section	Forty-acre Tract	Number Acres To Be Irrigated	Date of Reclamation
10 S.	2 W.	10	SW 1/4 of SE 1/4	8.5	July 15, 1953
10 S.	2 W.	15	NW 1/4 of NE 1/4	16.5	" "
				25.0	

Beginning at the quarter section corner on the North boundary line of Sec. 15 in T. 10 S., R. 2 W. of the Will. Mer., and running thence South 22.60 chains to the Southwest corner of Lot 2 in said Section 15; thence East 29.68 chains along the South line of Lots 1 and 2 in said Section 15; thence North 24.47 chains to the Southern boundary line of the right of way of the Willamette Valley and Coast Railroad Company; thence S. 45°45' W. along the Southern boundary line of said right of way to a point which is 14.62 chains East of the West boundary line of the Northeast quarter of said Sec. 15; thence North 28.21 chains to the South line of the D.L.C. of Lewis Stewart and wife, Cl. 54 in said township and range; thence S. 55°30' W. along the Southern boundary line of said Cl. 54, 17.53 chains to a point due North of the place of beginning; thence South 6.80 chains to the place of beginning; Subject, however to the right of way of said Willamette Valley and Coast Railroad Co.; and Subject to the rights of the public in roads.


15. If the ground water supply is supplemental to an existing water supply, identification of any application for a permit, permit, certificate or adjudicated right to appropriate water made or held by the registrant.

Township 10 S. Range 2 W. W.M.  
North

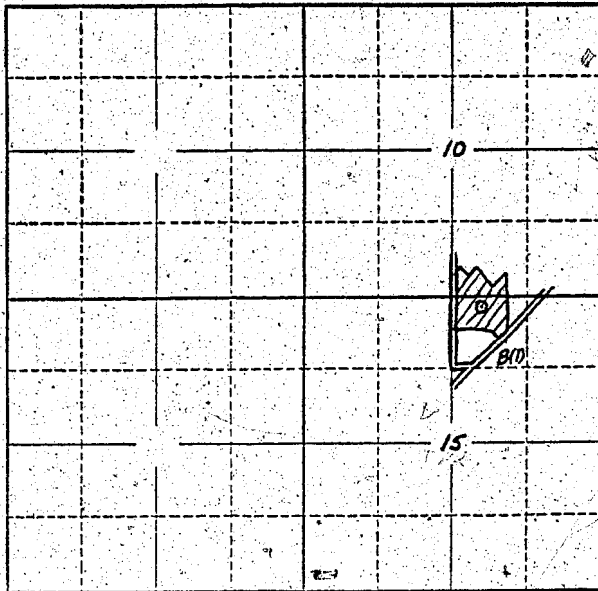

Locate well and acreage of irrigated land on plat.  
Scale: 2" = 1 Mile

STATE OF OREGON

County of Linn } ss.

I, Donald A. Bell, being first duly sworn, do hereby certify that I have read the foregoing Registration Statement and that all of the items therein contained are true to the best of my knowledge and belief.

Donald A. Bell  
(Signature of Registrant)

Subscribed and sworn to before me this 11th day of June, 1956

My commission expires June 8 - 1957  
Raymond Stevenson  
(Notary Public)

(SEAL)

CERTIFICATE OF REGISTRATION

STATE OF OREGON

County of Marion } ss.

This is to certify that the foregoing Registration Statement was received in the office of the State Engineer on the 11th day of June, 1956, at 6 o'clock A. M. and has been duly recorded in said office in Book No. 1 of Registration Statements on page GR-180 C


Witness my hand this 8th day of October, 1956

Lewis A. Stanley  
(State Engineer)

By \_\_\_\_\_ (Deputy)

GR-180 C