

Registration Statement

OF CLAIMANT OF RIGHT TO APPROPRIATE GROUND WATER

TO THE STATE ENGINEER OF OREGON:

I, MR QUAY CALBETH SNODGRASS
of PO BOX 340A WILSONVILLE County of CLATSOP
(Mailing address)

State of OREGON, do hereby make application for a certificate of registration as evidence of a right to appropriate ground water.

1. Source from which water is withdrawn is PUMP WELL
(Flowing well, pump well, infiltration trench, or tunnel)

2. Location is: ABOUT 500 FT NORTH OF SUBDIVIDED LOT
(Approximate distance and direction from nearest city or town) IN WILSONVILLE

and is more particularly described as follows: 1100 feet South & 350 feet West from NE corner Sect. 23.

(a) ~~ABOUT 1/2 MILE WEST OF SECTION 9 1500 FT EAST OF RIVER~~
NORTH NEW (Give distance and bearing to corner of section or other legal subdivision)

being within TA 204 of Sec. 23, Twp. 3 S, Rge. 1 W
(Smallest legal subdivision) (N. or S.) (E. or W.)

or (b) within limits of recorded platted property, town or city: _____

in Lot _____, Block _____ of _____
(Name of plat or addition)

County of _____
(If within city or town, give name)

3. Construction Work was begun on WELL DRILLED ABOUT 1915; was completed on _____
(Date) (Date)

and the ground water claimed was first used for the purposes set out below on JUNE 1 1945
(Date)

since which time the water has been used EACH YEAR
(Continuously or intermittently)

from JUNE 1 to SEP 20
(Date) (Date)

4. Quantity of water claimed and used is 20 gallons per minute; _____ acre feet per year.

5. Purpose or Purposes for which water is used IRRIGATION AT PRESENT
BUT DOMESTIC & IRRIGATION WITHIN 2 MILES
(Domestic, irrigation, municipal, manufacturing, industrial, etc.)

6. Description of Well: Depth 55 feet. Type DRILLED
(Dug or drilled)

diameter 6" inches. Elevation of ground at well site ABOUT 130 feet, mean sea level.
(As near as known)


Depth to water table 35 feet.

7. Capacity of Well: WE HAVE PUMPED 200 GPM FOR 1 1/2 HRS
A DAY THROUGH SUMMER MONTHS AND WELL
HAS NEVER BEEN DRY
g.p.m. with _____ feet drawdown.
g.p.m. with _____ feet drawdown.
Date of test _____

If Flowing Well: Measured discharge _____ g.p.m. on _____
(Date)

Shut-in pressure at ground surface _____ lbs. per sq. in. on _____
(Date)

Township 3S Range 1W, W.M.
North

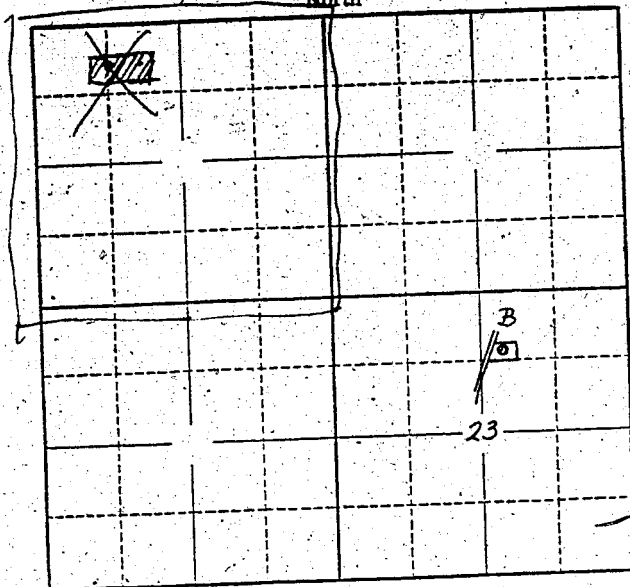

~~SECTION 23~~

Locate well and acreage of irrigated land on plat.
Scale: 2" = 1 Mile

STATE OF OREGON

County of CLACKAMAS } ss.

I, Quay C Snodgrass, being first duly sworn, do hereby certify that I have read the foregoing Registration Statement and that all of the items therein contained are true to the best of my knowledge and belief.

Quay C Snodgrass
(Signature of Registrant)

Subscribed and sworn to before me this 7th day of July, 1958.

My commission expires NOV 28 1958

[Signature]
(Notary Public)

(SEAL)

CERTIFICATE OF REGISTRATION

STATE OF OREGON

County of Marion } ss.

This is to certify that the foregoing Registration Statement was received in the office of the State Engineer on the 8th day of July, 1958, at 8:00 o'clock A.M. and has been duly recorded in said office in Book No. 8 of Registration Statements on page GR-1877.

Witness my hand this 26th day of January, 1959.

[Signature]
(State Engineer)

By _____ (Deputy)

#1500

GR-1877