

# Registration Statement

## OF CLAIMANT OF RIGHT TO APPROPRIATE GROUND WATER

(Under Chapter 708, Oregon Laws 1955.)

TO THE STATE ENGINEER OF OREGON:

I, Rudolph R. Mayer

of Rt 2 Cornelius County of Washington

State of Oregon, do hereby make application for a certificate of registration as evidence of a right to appropriate ground water.

- 1. Source from which water is withdrawn is Pump well  
(Flowing well, pump well, infiltration trench, or tunnel)
- 2. Location is: 4 miles south of Cornelius on Iowa Hill Rd.  
(Approximate distance and direction from nearest city or town)

and is more particularly described as follows:

(a) 1850' S 110° 20' E from N.W. corner of Section 22  
(Give distance and bearing to corner of section or other legal subdivision)

being within S.W. 1/4 of NW 1/4 of Sec. 22, Twp. 1 S. Rge. 3 W.  
(Smallest legal subdivision) (N. or S.) (E. or W.)

or (b) within limits of recorded platted property, town or city:

in Lot \_\_\_\_\_, Block \_\_\_\_\_ of \_\_\_\_\_  
(Name of plat or addition)

County of \_\_\_\_\_  
(If within city or town, give name)

3. Construction Work was begun on Sept. 1949 and was completed on Sept. 1949  
(Date) (Date)

and the ground water claimed was first used for the purposes set out below on May 1950  
(Date)

since which time the water has been used Continuously  
(Continuously or intermittently)

from May 1950 to March 1958  
(Date) (Date)

4. Quantity of water claimed and used is 250 gallons per minute; 100 acre feet per year.

5. Purpose or Purposes for which water is used Irrigation and Domestic

(Domestic, irrigation, municipal, manufacturing, industrial, etc.)

6. Description of Well: Depth 165 feet. Type drilled  
(Dug or drilled)

diameter 6 inches. Elevation of ground at well site \_\_\_\_\_ feet, mean sea level.  
(As near as known)

Depth to water table 41 feet.

7. Capacity of Well: 200 g.p.m. with 50 feet drawdown.  
\_\_\_\_\_ g.p.m. with \_\_\_\_\_ feet drawdown.

Date of test 1950

If Flowing Well: Measured discharge \_\_\_\_\_ g.p.m. on \_\_\_\_\_  
(Date)

Shut-in pressure at ground surface \_\_\_\_\_ lbs. per sq. in. on \_\_\_\_\_  
(Date)

Water is controlled by \_\_\_\_\_  
(Cap, valve, etc.)

8. Casing: (Give diameter, commercial specifications and depth below ground surface of each casing size.)

6" inch diameter from 0 to 118 feet  
 inch diameter from to feet  
 inch diameter from to feet  
 inch diameter from to feet

Describe and show depth of shoe, plug, adapter, liner or other details:

Shoe is at 118 feet anchored in rock with no casing below this point.

9. Perforated Casings or Screens:

About 6 perforations per foot of pipe from 95' to 115'

(Number per foot and size of perforations, or describe screen)

from to

from to

from to

10. Log of Well: (Describe each stratum or formation clearly, indicate if water bearing, and give thickness and depth as indicated.)

MATERIAL	Thickness (Feet)	Depth to Bottom (Feet)
Soil & clay first 65 feet which was originally hand dug	65	65
Blue clay same boulders	22	87
Yellow soft rock	26	113
Grey rock	5	118
Grey basalt	24	142
Soft grey rock (water)	13	155
Gray basalt	10	165

If log of well is not available, give name and address of driller. Harty Brothers  
3115 SW. Illinois St. Portland 1 Oregon

11. Infiltration Trench: Covered or open \_\_\_\_\_  
 Dimensions: Length \_\_\_\_\_ ft. Minimum depth \_\_\_\_\_ ft. Maximum depth \_\_\_\_\_ ft.  
 Bottom width \_\_\_\_\_ ft. Discharge \_\_\_\_\_ g.p.m. Date of test \_\_\_\_\_

12. Tunnel: Type of lining \_\_\_\_\_  
 Dimensions: \_\_\_\_\_  
(Length, course, and cross sectional size)  
 Position of water bearing stratum with reference to portal of tunnel \_\_\_\_\_

Log of tunnel: (Preceding table for log of well may be used, if desired. Give footage from portal and character of materials, as pertinent.)


13. Pumping Equipment:  
 (a) Pump Peerless Turbine Capacity 200 g.p.m. under pressure  
(Make, type and size)  
 (b) Motor 15 H.P. 3phase G.E. motor  
(Type and horsepower)

14. Location of area irrigated or to be irrigated, or place of use if for purposes other than irrigation.

Township North or South	Range E. or W. of Willamette Meridian	Section	Forty-acre Tract	Number Acres To Be Irrigated	Date of Reclamation
15	3W	22	NW 1/4 of NW 1/4	5.3	1950
15	3W	22	NE 1/4 of NW 1/4	6.3	1950
15	3W	22	SW 1/4 of NW 1/4	11.3	1950
15	3W	22	SE 1/4 of NW 1/4	9.0	1950
				<u>31.9</u>	

15. If the ground water supply is supplemental to an existing water supply, identification of any application for a permit, permit, certificate or adjudicated right to appropriate water made or held by the registrant.

Township 1S Range 3W W.M.  
North

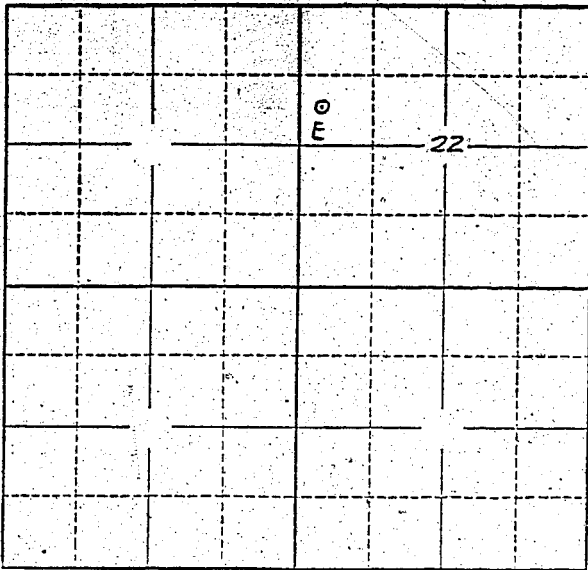

Locate well and acreage of irrigated land on plat.  
Scale: 2" = 1 Mile

STATE OF OREGON

County of Marion } ss.

I, Rudolph A. Meyer, being first duly sworn, do hereby certify that I have read the foregoing Registration Statement and that all of the items therein contained are true to the best of my knowledge and belief.

Rudolph A. Meyer  
(Signature of Registrant)

Subscribed and sworn to before me this 26th day of March, 1958

My commission expires 12th June 1961 Wm. S. Baithamer  
(Notary Public)

(SEAL)

**CERTIFICATE OF REGISTRATION.**

STATE OF OREGON }  
County of Marion } ss.

This is to certify that the foregoing Registration Statement was received in the office of the State Engineer on the 5th day of July, 1958, at 8:00 o'clock A.M. and has been duly recorded in said office in Book No. 8 of Registration Statements on page GR-1878

~~Construction of the bed completed by 13 and the water completely applied to the field by 13~~

Witness my hand this 26th day of January, 1959

Laura A. Steiner  
(State Engineer)

\$15.30

By \_\_\_\_\_ (Deputy)

GR-1878