

Registration Statement

REGISTRATION NO. GR-1954
CERTIFICATE NO. GR-4102

RECEIVED
AUG 8 1960
STATE ENGINEER
SALMON DIVISION

OF CLAIMANT OF RIGHT TO APPROPRIATE GROUND WATER
(Under Chapter 708, Oregon Laws 1955.)

TO THE STATE ENGINEER OF OREGON:

I, Frederick William Jungar

of Rt. 1 Box 219 Forest Grove County of Washington

State of Oregon, do hereby make application for a certificate of registration as evidence of a right to appropriate ground water.

1. Source from which water is withdrawn is two pump wells
(Flowing well, pump well, infiltration trench, or tunnel)

2. Location is: 3 miles West of Forest Grove
(Approximate distance and direction from nearest city or town)

and is more particularly described as follows: 1120 feet east & 400 feet south from N 1/4 corner

(a) On base line
(Give distance and bearing to corner of section or other legal subdivision)

being within NW 1/4 NE 1/4 of Sec. 3, Twp. 1 S, Rge. 4 W
(Smallest legal subdivision) (S or W) (E or W)

or (b) within limits of recorded platted property, town or city:

in Lot _____, Block _____ of _____
(Name of plat or addition)

County of Washington

(If within city or town, give name)

3. Construction Work was begun on 5/1/49; was completed on 5/16/49
(Date) (Date)

and the ground water claimed was first used for the purposes set out below on 5/16/58
(Date)

since which time the water has been used continuously
(Continuously or intermittently)

from May 49 to June 58
(Date) (Date)

4. Quantity of water claimed and used is 6 gallons per minute; _____ acre feet per year.

5. Purpose or Purposes for which water is used Domestic and Garden (2⁰⁰ Acres)
(Domestic, irrigation, municipal, manufacturing, industrial, etc.)

6. Description of Well: Depth 511 1/2 feet. Type Drilled
(Dug or drilled)

diameter 6 1/2 inches. Elevation of ground at well site 150 feet, mean sea level.
(As near as known)

Depth to water table 40 feet.

7. Capacity of Well: 12 g.p.m. with 40 feet drawdown.
_____ g.p.m. with _____ feet drawdown.


Date of test 5/49

If Flowing Well: Measured discharge _____ g.p.m. on _____
(Date)

Shut-in pressure at ground surface _____ lbs. per sq. in. on _____
(Date)

Water is controlled by _____
(Cup, valve, etc.)

Township 15 Range 4W W.M.

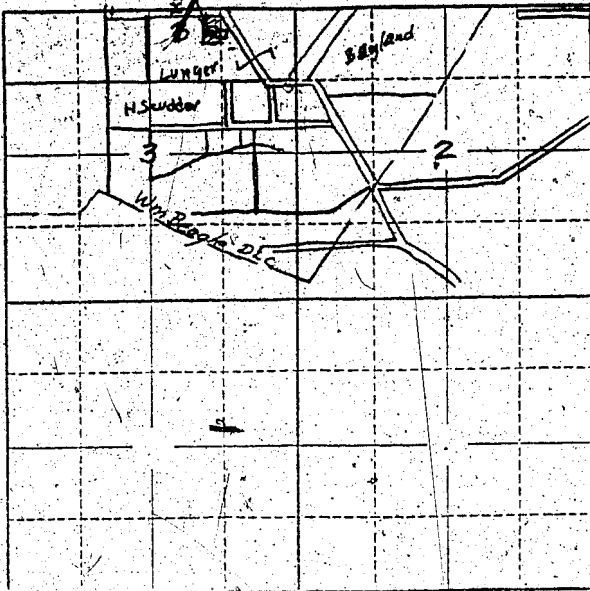

Locate well and acreage of irrigated land on plat.
Scale: 2" = 1 Mile

STATE OF OREGON

County of Washington ss.

I, Fredrick William Lungert being first duly sworn, do hereby certify that I have read the foregoing Registration Statement and that all of the items therein contained are true to the best of my knowledge and belief.

Fredrick William Lungert
(Signature of Registrant)

Subscribed and sworn to before me this 25 day of June, 1958

My commission expires Sept 24, 1958 Floyd C. Sharp
(Notary Public)

(SEAL)

NOTARY PUBLIC FOR OREGON
My Commission Expires Sept. 24, 1958

CERTIFICATE OF REGISTRATION

STATE OF OREGON }
County of Marion } ss.

This is to certify that the foregoing Registration Statement was received in the office of the State Engineer on the 5th day of July, 1958, at 8.00 o'clock A. M. and has been duly recorded in said office in Book No. 17 of Registration Statements on page GR-4102.

~~Registration shall be completed by xxxxxxxxxxxxxxxxx 10 xxx and the water completely applied to xxxxxxxxx by xxxxxxxxxxxxxxxxx 19 xxx.~~

Witness my hand this 18th day of October, 1960

Lawrence A. Stanley
(State Engineer)

By _____ (Deputy)

GR-4102

#15.00