

Registration Statement

OF CLAIMANT OF RIGHT TO APPROPRIATE GROUND WATER

TO THE STATE ENGINEER OF OREGON:

I, B. H. Schroeder
of 4421 S.E. Pineshurst Portland 22 County of Clatsop
(Mailing address)

State of Oregon, do hereby make application for a certificate of registration as evidence of a right to appropriate ground water.

1. Source from which water is withdrawn is Well, Pumped
(Flowing well, pump well, infiltration trench, or tunnel)

2. Location is: 4 miles north of Oregon City. Shown as Oakgrove
(Appropriate distance and direction from nearest city or town)

and is more particularly described as follows:

(a) Well is on lot at end of Pineshurst Ave
(Give distance and bearing to corner of section or other legal subdivision)

being within of Sec. 6, Twp. 2S, Rge. 2E
(Smallest legal subdivision) (N. or S.) (E. or W.)

or (b) within limits of recorded platted property, town or city:

in Lot , Block of
(Name of plat or addition)

(If within city or town, give name) County of

3. Construction Work was begun on 1947; was completed on 1947
(Date) (Date)

and the ground water claimed was first used for the purposes set out below on 1947
(Date)

since which time the water has been used irrigate
(Continuously or intermittently)

from May to October
(Date) (Date)

4. Quantity of water claimed and used is \$ 25 gallons per minute; acre feet per year.

5. Purpose or Purposes for which water is used Irrigation

(Domestic, irrigation, municipal, manufacturing, industrial, etc.)

6. Description of Well: Depth 380 feet. Type Drilled
(Dug or drilled)

diameter 6 inches. Elevation of ground at well site 80 ft feet, mean sea level.
(As nearly known)

Depth to water table 100 feet.

7. Capacity of Well: g.p.m. with feet drawdown. Has never run dry

 g.p.m. with feet drawdown.

Date of test No test

If Flowing Well: Measured discharge g.p.m. on
(Date)

Shut-in pressure at ground surface lbs. per sq. in. on
(Date)

Water is controlled by
(Cap, valve, etc.)

8. **Casing:** (Give diameter, commercial specifications and depth below ground surface of each casing size.)

6 inch diameter from 0 to 10 feet
 inch diameter from to feet
 inch diameter from to feet
 inch diameter from to feet

Describe and show depth of shoe, plug, adapter, liner or other details:

9. **Perforated Casings or Screens:**

(Number per foot and size of perforations, or describe screen) from to

..... from to

..... from to

..... from to

10. **Log of Well:** (Describe each stratum or formation clearly, indicate if water bearing, and give thickness and depth as indicated.)

MATERIAL	Thickness (Feet)	Depth to Bottom (Feet)
Rock	0	280 290
Black sand	290 290	290 300

If log of well is not available, give name and address of driller: Joe. Plant

11. Infiltration Trench: Covered or open _____
Dimensions: Length _____ ft. Minimum depth _____ ft. Maximum depth _____ ft.
Bottom width _____ ft. Discharge _____ g.p.m. Date of test _____

12. Tunnel: Type of lining _____
Dimensions: _____ (Length, course, and cross sectional size)
Position of water bearing stratum with reference to portal of tunnel _____

Log of tunnel: (Preceding table for log of well may be used, if desired. Give footage from portal and character of materials, as pertinent.)

13. Pumping Equipment:
(a) Pump Myers Deep Well Piston Capacity ~~10~~²⁵ ~~15~~ g.p.m.
(b) Motor 1 HP (Type and horsepower)


14. Location of area irrigated or to be irrigated, or place of use if for purposes other than irrigation.

Township North or South	Range E. or W. of Willamette Meridian	Section	Forty-acre Tract	Number Acres To Be Irrigated	Date of Reclamation
<u>25</u>	<u>2E</u>	<u>6</u>	<u>NW¹/₄ SW¹/₄</u>	<u>1.0</u>	<u>1947</u>
<u>"</u>	<u>"</u>	<u>"</u>	<u>SW¹/₄ SW¹/₄</u>	<u>2.0</u>	<u>1947</u>
				<u>3.0</u>	

15. If the ground water supply is supplemental to an existing water supply, identification of any application for a permit, permit, certificate or adjudicated right to appropriate water made or held by the registrant.

None

Township 25 Range 2E W.M.
North

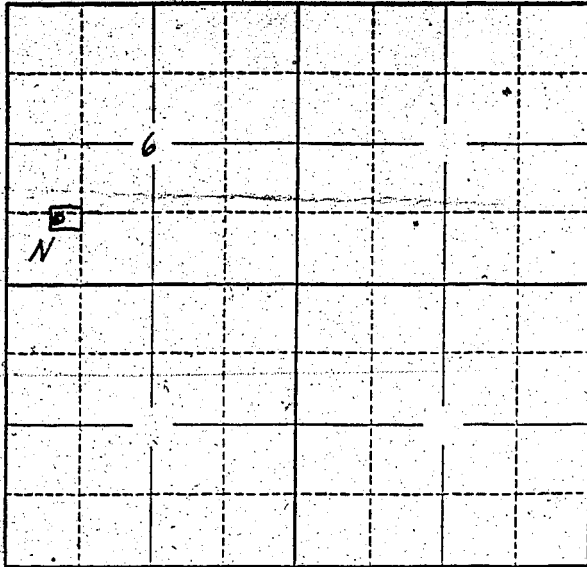

Locate well and acreage of irrigated land on plat.
Scale: 2" = 1 Mile

STATE OF OREGON

County of Marion } ss.

I, D. H. Schroeder, being first duly sworn, do hereby certify that I have read the foregoing Registration Statement and that all of the items therein contained are true to the best of my knowledge and belief.

D. H. Schroeder
(Signature of Registrant)

Subscribed and sworn to before me this 6th day of June, 1958

My commission expires 12th June 1961

Wm. S. Bartholomew
(Notary Public)

(SEAL)

CERTIFICATE OF REGISTRATION

STATE OF OREGON

County of Marion } ss.

This is to certify that the foregoing Registration Statement was received in the office of the State Engineer on the 6th day of July, 1958, at 8:00 o'clock A.M. and has been duly recorded in said office in Book No. 8 of Registration Statements on page GR-1879

Witness my hand this 26th day of January, 1959

Laura A. Stanley
(State Engineer)

\$ 15.00

By _____

(Deputy)

GR - 1879