

Registration Statement

OF CLAIMANT OF RIGHT TO APPROPRIATE GROUND WATER

TO THE STATE ENGINEER OF OREGON:

I, Leonard Nitka

of Route 2 Box 193A Corvallis County of Lenton
(Mailing address)

State of Oregon, do hereby make application for a certificate of registration as evidence of a right to appropriate ground water.

1. Source from which water is withdrawn is Pump Well
(Flowing well, pump well, infiltration trench, or tunnel)

2. Location is: 4 miles south Philomath Ore
(Approximate distance and direction from nearest city or town)

and is more particularly described as follows:

2784.5 feet east of northwest corner of donation claim Nos. 66
(a) and 42 and 412.5 feet south of north line of claims
(Give distance and bearing to corner of section or other legal subdivision)

being within NE 1/4 NW 1/4 of Sec. 31, Twp. 12S, Rge. 5W
(Smallest legal subdivision) (N. or S.) (E. or W.)

or (b) within limits of recorded platted property, town or city:

in Lot _____, Block _____ of _____
(Name of plat or addition)

County of _____
(If within city or town, give name)

3. Construction Work was begun on July 25, 1955; was completed on Aug 1, 1955
(Date) (Date)

and the ground water claimed was first used for the purposes set out below on Aug 1, 1955
(Date)

since which time the water has been used Intermittently
(Continuously or Intermittently)

from Aug 1, 1955 to June 25, 1958
(Date) (Date)

4. Quantity of water claimed and used is 2.25 gallons per minute; _____ acre feet per year.

5. Purpose or Purposes for which water is used Irrigation and domestic

(Domestic, irrigation, municipal, manufacturing, industrial, etc.)

6. Description of Well: Depth 94 feet. Type Drilled
(Dug or drilled)

diameter 6 inches. Elevation of ground at well site 80 feet, mean sea level.
(As near as known)

Depth to water table 15 feet.

7. Capacity of Well: 150 g.p.m. with 25 feet drawdown.

225 g.p.m. with 40 feet drawdown.

Date of test Aug 1, 1955

If Flowing Well: Measured discharge _____ g.p.m. on _____
(Date)

Shut-in pressure at ground surface _____ lbs. per sq. in. on _____
(Date)

Water is controlled by _____
(Cap, valve, etc.)


Township 12S Range 5W, W.M.

North

Bellfountain Road

NW corner Claims 66-42

DLC Corner

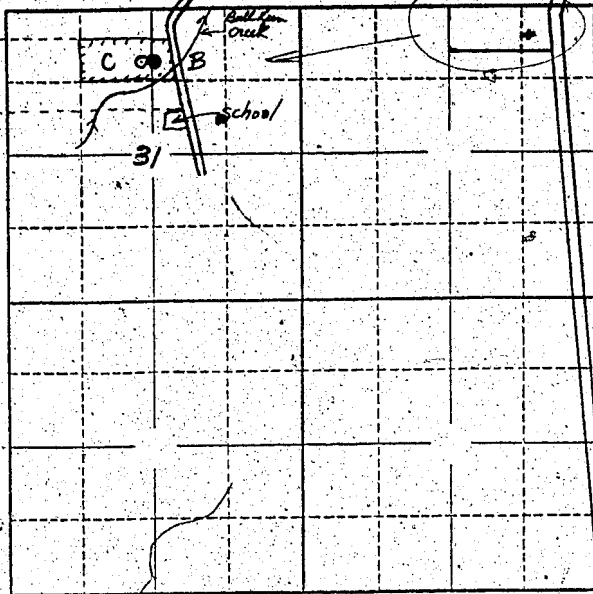

Locate well and acreage of irrigated land on plat.

Scale: 2" = 1 Mile

STATE OF OREGON

County of Benton

ss.

I, Leonard Nitka, being first duly sworn, do hereby certify that I have read the foregoing Registration Statement and that all of the items therein contained are true to the best of my knowledge and belief.

Leonard Nitka
(Signature of Registrant)

Subscribed and sworn to before me this 7th day of July, 1958

My commission expires Sept. 29, 1961

Margaret B. [unclear]
(Notary Public)

(SEAL)

CERTIFICATE OF REGISTRATION

STATE OF OREGON

County of Marion

ss.

This is to certify that the foregoing Registration Statement was received in the office of the State Engineer on the 27th day of July, 1958, at 9:00 o'clock A.M. and has been duly recorded in said office in Book No. 16 of Registration Statements on page GR-3850

Witness my hand this 28th day of December, 1959

Lewis A. Stanley
(State Engineer)

By _____ (Deputy)

GR 3850

#15.20