

Registration Statement

OF CLAIMANT OF RIGHT TO APPROPRIATE GROUND WATER

TO THE STATE ENGINEER OF OREGON:

I, W. L. Racette & R. Racette

of Aurora, Oregon County of Marion

State of Oregon, do hereby make application for a certificate of registration as evidence of a right to appropriate ground water.

1. Source from which water is withdrawn is Pump Well
(Flowing well, pump well, infiltration trench, or tunnel)

2. Location is: 3 1/2 miles Northwest of Aurora
(Approximate distance and direction from nearest city or town)

and is more particularly described as follows:

(a) North 1885 ft and West 779 ft from S. 1/4 Sec. 5
(Give distance and bearing to corner of section or other legal subdivision)

being within N.E. & S.E. 1/4 of Sec. 5, Twp. 4 S, Rge. 1 W
(Smallest legal subdivision) (N. or S.) (E. or W.)

or (b) within limits of recorded platted property, town or city: Fargo Orchard Tr.

in Lot 2, Block 3, of Fargo Orchard Tr.
(Name of plat or addition)

(If within city or town, give name) County of Marion

3. Construction Work was begun on Fall 1949, was completed on Fall 1949
(Date) (Date)

and the ground water claimed was first used for the purposes set out below on Spring 1950
(Date)

since which time the water has been used intermittently during season
(Continuously or intermittently)

from 1950 to Oct. 1957
(Date) (Date)

4. Quantity of water claimed and used is 570 gallons per minute; 194 cu. ft. sec. acre feet per year.

5. Purpose or Purposes for which water is used Irrigation & stock water

(Domestic, irrigation, municipal, manufacturing, industrial, etc.)

6. Description of Well: Depth 162 feet. Type Drilled
(Dug or drilled)

diameter 10 inches. Elevation of ground at well site _____ feet, mean sea level.
(As near as known)

Depth to water table 8 feet. Spring

7. Capacity of Well: 1300 g.p.m. with 128 feet drawdown. after 4 hrs.

_____ g.p.m. with _____ feet drawdown.

Date of test Summer 1956

If Flowing Well: Measured discharge _____ g.p.m. on _____
(Date)

Shut-in pressure at ground surface _____ lbs. per sq. in. on _____
(Date)

Water is controlled by _____
(Cap, valve, etc.)

If log of well is not available, give name and address of driller.

J. Beck - Canby

11. Infiltration Trench: Covered or open _____
 Dimensions: Length _____ ft. Minimum depth _____ ft. Maximum depth _____ ft.

Bottom width _____ ft. Discharge _____ g.p.m. Date of test _____

12. Tunnel: Type of lining _____

Dimensions: _____
(Length, course, and cross sectional size)

Position of water bearing stratum with reference to portal of tunnel _____

Log of tunnel: (Preceding table for log of well may be used if desired. Give footage from portal and character of materials, as pertinent.)

13. Pumping Equipment:

(a) Pump *Peerless - Turbine* _____ Capacity *600* g.p.m.
(Make, type and size)


(b) Motor *30HP. GE, Electric* _____
(Type and horsepower)

14. Location of area irrigated or to be irrigated, or place of use if for purposes other than irrigation.

Township North or South	Range E. or W. of Williams-Meridian	Section	Forty-acre Tract	Number Acres To Be Irrigated	Date of Reclamation
4 S.	1 W.	5	S.E. $\frac{1}{4}$ S.E. $\frac{1}{4}$	28.97	1950
"	"	"	N.E. $\frac{1}{4}$ S.E. $\frac{1}{4}$	39.40	"
"	"	"	S.W. $\frac{1}{4}$ S.E. $\frac{1}{4}$	11.66	"
"	"	"	N.W. $\frac{1}{4}$ S.E. $\frac{1}{4}$	39.45	"
"	"	"	N.E. $\frac{1}{4}$ S.W. $\frac{1}{4}$	2.32	"
"	"	"	S.E. $\frac{1}{4}$ N.W. $\frac{1}{4}$.55	"
"	"	"	S.W. $\frac{1}{4}$ N.E. $\frac{1}{4}$	10.85	"
"	"	"	S.E. $\frac{1}{4}$ N.E. $\frac{1}{4}$	15.84	"
4 S.	1 W.	4	S.W. $\frac{1}{4}$ S.W. $\frac{1}{4}$	4.76	
"	"	"	N.W. $\frac{1}{4}$ S.W. $\frac{1}{4}$.84	
				<u>154.64</u> Total	
					Total 154.64

15. If the ground water supply is supplemental to an existing water supply, identification of any application for a permit, permit, certificate or adjudicated right to appropriate water made or held by the registrant.

Township 4S Range 1W, W.M.
North

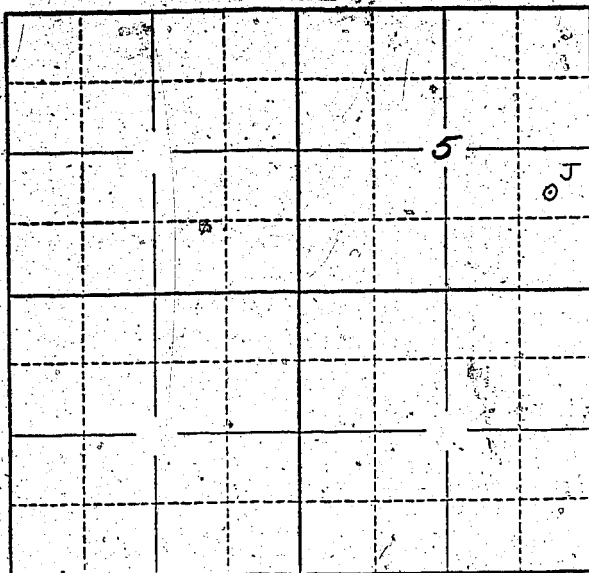

Locate well and acreage of irrigated land on plat.
Scale: 2" = 1 Mile

STATE OF OREGON

County of Marion } ss.

Richard Racette, being first duly sworn, do hereby certify that I have read the foregoing Registration Statement and that all of the items therein contained are true to the best of my knowledge and belief.

Richard Racette
(Signature of Registrant)

Subscribed and sworn to before me this 8th day of July, 1958

My commission expires 12th June 1961 Wm. S. Bartholomew
(Notary Public)

(SEAL)

CERTIFICATE OF REGISTRATION

STATE OF OREGON

County of Marion } ss.

This is to certify that the foregoing Registration Statement was received in the office of the State Engineer on the 8th day of July, 1958, at 1:00 o'clock PM and has been duly recorded in said office in Book No. 9 of Registration Statements on page GR-1888

Witness my hand this 26th day of January, 1959

Lewis A. Stanley
(State Engineer)

By _____ (Deputy)

GR - 1888

28-35