

Registration Statement

OF CLAIMANT OF RIGHT TO APPROPRIATE GROUND WATER

TO THE STATE ENGINEER OF OREGON:

I, Frank S. Perry

of Route 3, Scio County of Linn
(Mailing address)

State of Oregon, do hereby make application for a certificate of registration as evidence of a right to appropriate ground water.

1. Source from which water is withdrawn is pump well
(Flowing well, pump well, infiltration trench, or tunnel)

2. Location is: 7 miles SW of Scio, Oregon
(Approximate distance and direction from nearest city or town)

and is more particularly described as follows:

(a) S. 60° 15' W. 27.5 chains from NE corner of S. 33, T. 10 S., R. 2 W.
(Give distance and bearing to corner of section or other legal subdivision)

being within NW 1/4 of NE 1/4 of Sec. 33, Twp. 10 S, Rge. 2 W
(Smallest legal subdivision) (N. or S.) (E. or W.)

or (b) within limits of recorded platted property, town or city:

in Lot _____, Block _____ of _____
(Name of plat or addition)

County of Linn
(If within city or town, give name)

3. Construction Work was begun on 1940, was completed on 1940
(Date) (Date)

and the ground water claimed was first used for the purposes set out below on 1940
(Date)

since which time the water has been used continuously
(Continuously or intermittently)

from 1940 to present time
(Date) (Date)

4. Quantity of water claimed and used is 300 gallons per minute; 63 acre feet per year.

5. Purpose or Purposes for which water is used Irrigation

(Domestic, irrigation, municipal, manufacturing, industrial, etc.)

6. Description of Well: Depth 30 feet. Type Drilled
(Dug or drilled)

diameter 10 inches. Elevation of ground at well site 245 feet, mean sea level.
(As near as known)

Depth to water table 10 feet.

7. Capacity of Well: 300 g.p.m. with 5 feet drawdown.

_____ g.p.m. with _____ feet drawdown.

Date of test Not tested - estimated

If Flowing Well: Measured discharge _____ g.p.m. on _____
(Date)

Shut-in pressure at ground surface _____ lbs. per sq. in. on _____
(Date)

Water is controlled by _____
(Cap, valve, etc.)

8. **Casing:** (Give diameter, commercial specifications and depth below ground surface of each casing size.)

10 ¹/₂ inch diameter **steel casing** from 0 to 30 feet
 _____ inch diameter _____ from _____ to _____ feet
 _____ inch diameter _____ from _____ to _____ feet
 _____ inch diameter _____ from _____ to _____ feet

Describe and show depth of shoe, plug, adapter, liner or other details: _____

9. **Perforated Casings or Screens:**

slot perforations from 12 to 30
(Number per foot and size of perforations, or describe screen)
 _____ from _____ to _____
 _____ from _____ to _____
 _____ from _____ to _____

10. **Log of Well:** (Describe each stratum or formation clearly, indicate if water bearing, and give thickness and depth as indicated.)

MATERIAL	Thickness (Feet)	Depth to Bottom (Feet)
Not available		

If log of well is not available, give name and address of driller. _____

11. Infiltration Trench: Covered or open _____

Dimensions: Length _____ ft. Minimum depth _____ ft. Maximum depth _____ ft.

Bottom width _____ ft. Discharge _____ g.p.m. Date of test _____

12. Tunnel: Type of lining _____

Dimensions: _____
(Length, course, and cross sectional size)

Position of water bearing stratum with reference to portal of tunnel _____

Log of tunnel: (Preceding table for log of well may be used, if desired. Give footage from portal and character of materials, as pertinent.)

13. Pumping Equipment:

(a) Pump 2" Fairbanks Morse Centrifugal Capacity 300 g.p.m.
(Make, type and size)

(b) Motor 10 H.P. electric
(Type and horsepower)


14. Location of area irrigated or to be irrigated, or place of use if for purposes other than irrigation.

Township North or South	Range E. or W. of Willamette Meridian	Section	Forty-acre Tract	Number Acres To Be Irrigated	Date of Reclamation
10 S	2 W	33	NE $\frac{1}{4}$ of NE $\frac{1}{4}$	7.0	1940
10 S	2 W	33	NW $\frac{1}{4}$ of NE $\frac{1}{4}$	16.0	"
10 S	2 W	33	SW $\frac{1}{4}$ of NE $\frac{1}{4}$	1.3	"
10 S	2 W	33	SE $\frac{1}{4}$ of NE $\frac{1}{4}$	0.9	"
				25.2	

Beginning at an iron rod on the East line of and South 3.75 chains distant from the Northeast corner of Section 33, in Township 10 South of Range 2 West of the Willamette Meridian, Oregon; thence South along the East line of said section 17.50 chains to an iron pipe; thence West parallel with the North line of said section 40.30 chains, to the West line of the Northeast quarter of said section; thence North 17.50 chains to a point which is South 3.75 chains distant from the Northwest corner of the Northeast quarter of said section; thence East 40.30 chains to the place of beginning, containing 70.52 acres, more or less, all lying and being in Linn County, State of Oregon.

15. If the ground water supply is supplemental to an existing water supply, identification of any application for a permit, permit, certificate or adjudicated right to appropriate water made or held by the registrant.

Township 10 S Range 2 W, W.M.
North

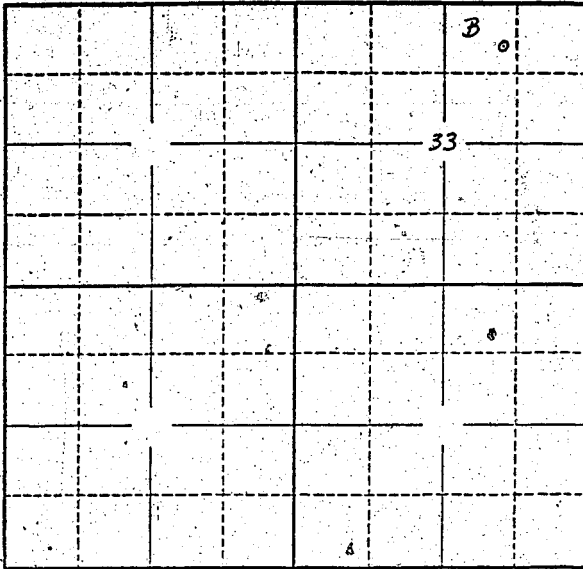

Locate well and acreage of irrigated land on plat.
Scale: 2" = 1 Mile

STATE OF OREGON

County of Linn } ss.

I, Frank S. Perry, being first duly sworn, do hereby certify that I have read the foregoing Registration Statement and that all of the items therein contained are true to the best of my knowledge and belief.

Frank S. Perry
(Signature of Registrant)

Subscribed and sworn to before me this 3 day of January, 1959

My commission expires Jan 3 - 1961

[Signature]
(Notary Public)

(SEAL)

CERTIFICATE OF REGISTRATION

STATE OF OREGON

County of Marion } ss.

This is to certify that the foregoing Registration Statement was received in the office of the State Engineer on the 8th day of July, 1958, at 1:00 o'clock P M. and has been duly recorded in said office in Book No. 9 of Registration Statements on page GR-1890

Witness my hand this 26th day of January

Lewis A. Stanley
(State Engineer)

\$15.00

By _____ (Deputy)

GR -1890