

# Registration Statement

## OF CLAIMANT OF RIGHT TO APPROPRIATE GROUND WATER

TO THE STATE ENGINEER OF OREGON:

I, Andrew Goldsby

of 3215 Chemawa Rd. Salem County of Marion

State of Oregon, do hereby make application for a certificate of registration as evidence of a right to appropriate ground water.

1. Source from which water is withdrawn is 3 pump well  
(Flowing well, pump well, infiltration trench, or tunnel)

2. Location is: three mi north of Salem  
(Approximate distance and direction from nearest city or town)

and is more particularly described as follows:

(a) 6.44 C&S east and 6.63 S south of Sec 36 Twp 6 Rge 3 W  
(Give distance and bearing to corner of section of other legal subdivision)

being within NW 1/4 of SW 1/4 of Sec. 36, Twp. 6, Rge. 3 W  
(Smallest legal subdivision) (N. or S.) (E. or W.)

or (b) within limits of recorded platted property, town or city:

in Lot \_\_\_\_\_, Block \_\_\_\_\_ of \_\_\_\_\_  
(Name of plat or addition)

County of \_\_\_\_\_  
(If within city or town, give name)

3. Construction Work was begun on May 1949, was completed on July 1949  
(Date) (Date)

and the ground water claimed was first used for the purposes set out below on May 1949  
(Date)

since which time the water has been used intermittently  
(Continuously or intermittently)

from April to October  
(Date) (Date)

4. Quantity of water claimed and used is 160 gallons per minute; 2 acre feet per year.

5. Purpose or Purposes for which water is used irrigation  
(Domestic, irrigation, municipal, manufacturing, industrial, etc.)

6. Description of Well: Depth 55 feet. Type drilled  
(Dug or drilled)

diameter 7 inches. Elevation of ground at well site 90 feet, mean sea level.  
(As near as known)

Depth to water table 18 feet.

7. Capacity of Well: \_\_\_\_\_ g.p.m. with \_\_\_\_\_ feet drawdown.

\_\_\_\_\_ g.p.m. with \_\_\_\_\_ feet drawdown.

Date of test \_\_\_\_\_

If Flowing Well: Measured discharge \_\_\_\_\_ g.p.m. on \_\_\_\_\_  
(Date)


Shut-in pressure at ground surface \_\_\_\_\_ lbs. per sq. in. on \_\_\_\_\_  
(Date)

Water is controlled by \_\_\_\_\_  
(Cap, valve, etc.)





Township 6 S Range 3 W, W.M.  
North

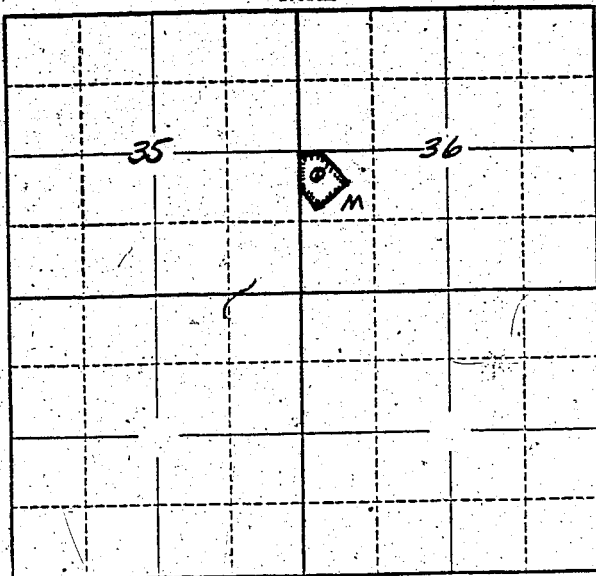

Locate well and acreage of irrigated land on plat.  
Scale: 2" = 1 Mile

STATE OF OREGON

County of MARION } ss.

I, ANDREW GOADSBY, being first duly sworn, do hereby certify that I have read the foregoing Registration Statement and that all of the items therein contained are true to the best of my knowledge and belief.

Andrew Goadsby  
(Signature of Registrant)

Subscribed and sworn to before me this 8<sup>th</sup> day of July, 1958

My commission expires 1-1-61  
R. K. Newton  
(Notary Public)

(SEAL)

**CERTIFICATE OF REGISTRATION**

STATE OF OREGON

County of Marion } ss.

This is to certify that the foregoing Registration Statement was received in the office of the State Engineer on the 8<sup>th</sup> day of July, 1958, at 5:00 o'clock P.M. and has been duly recorded in said office in Book No. 9 of Registration Statements on page GR-1898

Witness my hand this 26<sup>th</sup> day of January, 1959

Lewis A. Stanley  
(State Engineer)

By \_\_\_\_\_ (Deputy)

\$15.00

GR-1898