

Registration Statement

OF CLAIMANT OF RIGHT TO APPROPRIATE GROUND WATER

TO THE STATE ENGINEER OF OREGON:

I, RALPH R AND Edna YOUNCE

of 2170 N.W. Jackson School Rd., Hillsboro County of WASHINGTON
(Mailing address)

State of OREGON, do hereby make application for a certificate of registration as evidence of a right to appropriate ground water.

1. Source from which water is withdrawn is PUMP WELL
(Flowing well, pump well, infiltration trench, or tunnel)
2. Location is: 1/4 MI N Hillsboro
(Approximate distance and direction from nearest city or town)

and is more particularly described as follows:

(a) 2170' N 77° 0' W from SE COR Sec 30
(Give distance and bearing to corner of section or other legal subdivision)
being within SW SE of Sec. 30, Twp. 1 N, Rge. 2 W
(Smallest legal subdivision) (N. or S.) (E. or W.)

or (b) within limits of recorded platted property, town or city:

in Lot _____, Block _____ of _____
(Name of plat or addition)
County of WASHINGTON
(If within city or town, give name)

3. Construction Work was begun on MAY 1953; was completed on MAY 1953
(Date) (Date)
and the ground water claimed was first used for the purposes set out below on SEPT 1953
(Date)
since which time the water has been used Intermittently
(Continuously or intermittently)
from SEPT 1953 to 1958
(Date) (Date)

4. Quantity of water claimed and used is 20 gallons per minute; 4 acre feet per year.

5. Purpose or Purposes for which water is used Irrigation & Domestic
(Domestic, irrigation, municipal, manufacturing, industrial, etc.)

6. Description of Well: Depth 26 feet. Type Drilled
(Dug or drilled)
diameter 8 inches. Elevation of ground at well site 200 feet, mean sea level.
(As near as known)
Depth to water table 15 feet.

7. Capacity of Well: 20 g.p.m. with 4 feet drawdown.
_____ g.p.m. with _____ feet drawdown.


Date of test No test - Observed above during normal use

If Flowing Well: Measured discharge _____ g.p.m. on _____
(Date)

Shut-in pressure at ground surface NONE lbs. per sq. in. on _____
(Date)

Water is controlled by _____
(Cap, valve, etc.)

Township 1N Range 2W W.M.
North

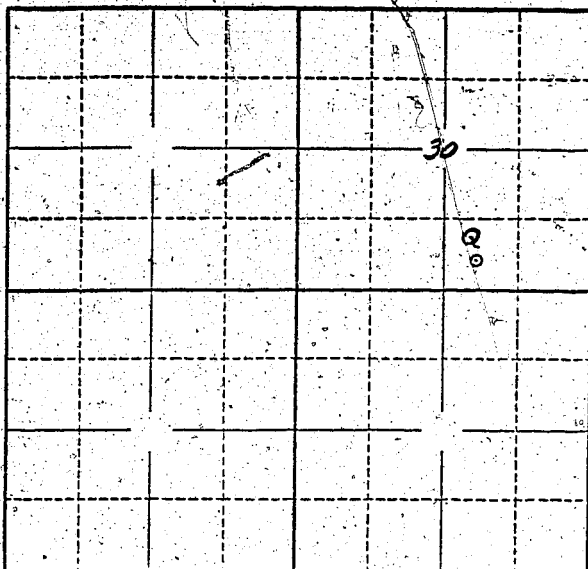

Locate well and acreage of irrigated land on plat.
Scale: 2" = 1 Mile

STATE OF OREGON

County of Marion } ss.

I, Ralph R. Younger, being first duly sworn, do hereby certify that I have read the foregoing Registration Statement and that all of the items therein contained are true to the best of my knowledge and belief.

Ralph R. Younger
(Signature of Registrant)

Subscribed and sworn to before me this 7th day of July, 1958

My commission expires 12th June 1961 Wm. S. Bartholomew
(Notary Public)

(SEAL)

CERTIFICATE OF REGISTRATION

STATE OF OREGON

County of Marion } ss.

This is to certify that the foregoing Registration Statement was received in the office of the State Engineer on the 9th day of July, 1958, at 8:00 o'clock A. M. and has been duly recorded in said office in Book No. 9 of Registration Statements on page GR-1905

Witness my hand this 9th day of February, 1959

\$15.00

Lewis A. Otisley
(State Engineer)

By _____
(Deputy)

GR - 1905