

# Registration Statement

## OF CLAIMANT OF RIGHT TO APPROPRIATE GROUND WATER

TO THE STATE ENGINEER OF OREGON:

I, William H. Baillie

of 1005 N. Church Street, - Salem County of Marion

State of Oregon, do hereby make application for a certificate of registration as evidence of a right to appropriate ground water.

1. Source from which water is withdrawn is Pump Well  
(Flowing well, pump well, infiltration trench, or tunnel)

2. Location is: 4.2 Miles N.W. of Woodburn, Marion County, Oregon  
(Approximate distance and direction from nearest city or town)

and is more particularly described as follows:

(a) 1490 Feet West & 1620 Feet North from S.E. Corner of Section 34  
(Give distance and bearing to corner of section or other legal subdivision)

being within N.W. 1/4 of S.E. 1/4 of Sec. 34, Twp. 1 S., Rge. 2 W.  
(Smallest legal subdivision) (N. or S.) (E. or W.)

or (b) within limits of recorded platted property, town or city:

in Lot \_\_\_\_\_, Block \_\_\_\_\_ of \_\_\_\_\_  
(Name of plat or addition)

County of \_\_\_\_\_  
(If within city or town, give name)

3. Construction Work was begun on 1944; was completed on 1944  
(Date) (Date)

and the ground water claimed was first used for the purposes set out below on 1944  
(Date)

since which time the water has been used Continuously during season  
(Continuously or intermittently)

from April 1944 to October 1957  
(Date) (Date)

4. Quantity of water claimed and used is 100 gallons per minute; \_\_\_\_\_ acre feet per year.

5. Purpose or Purposes for which water is used Irrigation

(Domestic, irrigation, municipal, manufacturing, industrial, etc.)

6. Description of Well: Depth 76 feet. Type Drilled  
(Dug or drilled)

diameter 12 inches. Elevation of ground at well site 97 feet, mean sea level.  
(As near as known)

Depth to water table 6 feet. (Surface in winter months)

7. Capacity of Well: 250 g.p.m. with ? feet drawdown.

\_\_\_\_\_ g.p.m. with \_\_\_\_\_ feet drawdown.

Date of test ?

If Flowing Well: Measured discharge \_\_\_\_\_ g.p.m. on \_\_\_\_\_  
(Date)

Shut-in pressure at ground surface \_\_\_\_\_ lbs. per sq. in. on \_\_\_\_\_  
(Date)

Water is controlled by \_\_\_\_\_  
(Cap, valve, etc.)

8. Casing: (Give diameter, commercial specifications and depth below ground surface of each casing size.)

12 inch diameter Concrete Tile from 0 to 76 feet  
inch diameter from to feet  
inch diameter from to feet  
inch diameter from to feet

Describe and show depth of shoe, plug, adapter, liner or other details:

9. Perforated Casings or Screens:

nil from 36 to  
(Number per foot and size of perforations, or describe screen)  
from to  
from to  
from to

10. Log of Well: (Describe each stratum or formation clearly, indicate if water bearing, and give thickness and depth as indicated.)

MATERIAL	Thickness (Feet)	Depth to Bottom (Feet)
Clay & sand		

If log of well is not available, give name and address of driller. Unknown

**11. Infiltration Trench: Covered or open** \_\_\_\_\_

Dimensions: Length \_\_\_\_\_ ft. Minimum depth \_\_\_\_\_ ft. Maximum depth \_\_\_\_\_ ft.  
 Bottom width \_\_\_\_\_ ft. Discharge \_\_\_\_\_ g.p.m. Date of test \_\_\_\_\_

**12. Tunnel: Type of lining** \_\_\_\_\_

Dimensions: \_\_\_\_\_  
(Length, course, and cross sectional size)  
 Position of water bearing stratum with reference to portal of tunnel \_\_\_\_\_

Log of tunnel: (Preceding table for log of well may be used, if desired. Give footage from portal and character of materials, as pertinent.)

**13. Pumping Equipment:**


(a) Pump Lane-Bowler - Turbine - 4 Inch Column Capacity 110 g.p.m.  
(Make, type and size)  
 (b) Motor 10 h.p. - single phase  
(Type and horsepower)

**14. Location of area irrigated or to be irrigated, or place of use if for purposes other than irrigation.**

Township North or South	Range E. or W. of Williamsite Meridian	Section	Forty-acre Tract	Number Acres To Be Irrigated	Date of Reclamation
T-4-S	R-2-W	34	N.E. $\frac{1}{4}$ of S.E. $\frac{1}{4}$	3.0	1944
"	"	"	N.W. $\frac{1}{4}$ of S.E. $\frac{1}{4}$	19.0	"
"	"	"	S.W. $\frac{1}{4}$ of S.E. $\frac{1}{4}$	5.0	"
"	"	"	S.E. $\frac{1}{4}$ of S.E. $\frac{1}{4}$	1.0	"
"	"	"	N.E. $\frac{1}{4}$ of S.W. $\frac{1}{4}$	23.0	"
"	"	"	S.E. $\frac{1}{4}$ of S.W. $\frac{1}{4}$	3.0	"
				54.0	

**15. If the ground water supply is supplemental to an existing water supply, identification of any application for a permit, permit, certificate or adjudicated right to appropriate water made or held by the registrant.**

Township 4-S Range 2-W, W.M.  
North

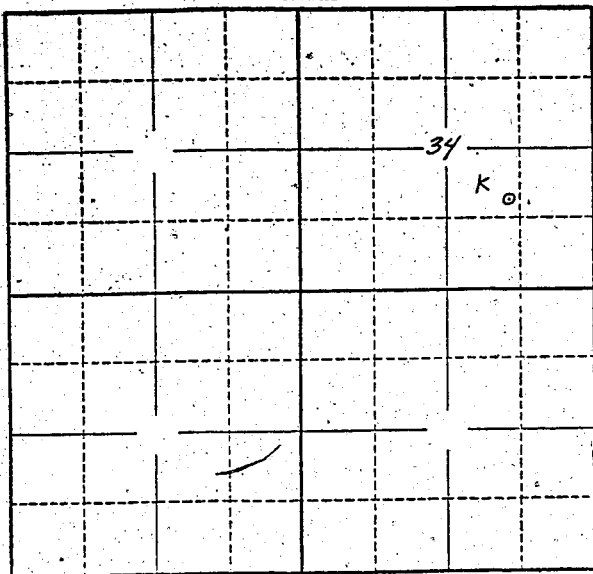

Locate well and acreage of irrigated land on plat.  
Scale: 2" = 1 Mile

STATE OF OREGON

County of Marion } ss.

I, William H. Baillie, being first duly sworn, do hereby certify that I have read the foregoing Registration Statement and that all of the items therein contained are true to the best of my knowledge and belief.

W H Baillie  
(Signature of Registrant)

Subscribed and sworn to before me this 9th day of July, 1958.

My commission expires 12th June 1961

Wm. S. Bartholomew  
(Notary Public)

(SEAL)

### CERTIFICATE OF REGISTRATION

STATE OF OREGON

County of Marion } ss.

This is to certify that the foregoing Registration Statement was received in the office of the State Engineer on the 9th day of July, 1958, at 10<sup>00</sup> o'clock A. M. and has been duly recorded in said office in Book No. 9 of Registration Statements on page GR-1907.

Witness my hand this 9th day of February, 1959.

Stuart A. Stanley  
(State Engineer)

By \_\_\_\_\_  
(Deputy)

\$18.60

GR-1907