RECEIVED
JUL 0 1958
STATE ENGINEER
SALEM, OREGON

Registration No. GR 1983

Certificate No. GR 1914

# Registration Statement

## OF CLAIMANT OF RIGHT TO APPROPRIATE GROUND WATER

**TO THE STATE ENGINEER OF OREGON:**

I, Henry Granat,

of Rt 3 Box 89, Hillsboro (Mailing address) County of Washington

State of Oregon, do hereby make application for a certificate of registration as evidence of a right to appropriate ground water.

1. **Source** from which water is withdrawn is Pump Well (Flowing well, pump well, infiltration trench, or tunnel)

2. **Location** is: 7 Miles North of Hillsboro (Approximate distance and direction from nearest city or town);

and is more particularly described as follows:

(a) 3100' S 37° 0' W from NE Corner Sec. 33. (Give distance and bearing to corner of section or other legal subdivision)

being within SW 1/4 of NE 1/4 (Smallest legal subdivision) of Sec. 33, Twp. 2 N (N. or S.), Rge. 2 W (E. or W.)

or (b) within limits of recorded platted property, town or city:

in Lot ....., Block ....., of ..... (Name of plat or addition)

..... (If within city or town, give name) County of Washington

3. **Construction Work** was begun on 1932 (Date); was completed on 1932 (Date)

and the ground water claimed was first used for the purposes set out below on 1932 (Date),

since which time the water has been used Irrigation - Intermittently (Continuously or intermittently)

from 1932 (Date) to 1958 (Date)

4. **Quantity** of water claimed and used is 6 gallons per minute; — acre feet per year.

5. **Purpose or Purposes** for which water is used Irrigation

..... (Domestic, irrigation, municipal, manufacturing, industrial, etc.)

6. **Description of Well:** Depth 325 feet. Type drilled (Dug or drilled)

diameter 8 inches. Elevation of ground at well site 600 (As near as known) feet, mean sea level.

Depth to water table 235 feet.

7. **Capacity of Well:** 6 g.p.m. with 235 feet drawdown.

..... g.p.m. with ..... feet drawdown.

Date of test No test

**If Flowing Well:** Measured discharge ..... g.p.m. on ..... (Date)

Shut-in pressure at ground surface ..... lbs. per sq. in. on ..... (Date)

Water is controlled by ..... (Cap, valve, etc.)

8. **Casing:** (Give diameter, commercial specifications and depth below ground surface of each casing size.)

8 inch diameter from 0 to 235 feet

inch diameter ROCK from 235 to 325 feet

inch diameter from to feet

inch diameter from to feet

Describe and show depth of shoe, plug, adapter, liner or other details:

9. **Perforated Casings or Screens:**

from to

(Number per foot and size of perforations, or describe screen.)

from to

from to

from to

10. **Log of Well:** (Describe each stratum or formation clearly, indicate if water bearing, and give thickness and depth as indicated.)

| MATERIAL | Thickness (Feet) | Depth to Bottom (Feet) |
|---|---|---|
| No log available. | | |

GR 1914

If log of well is not available, give name and address of driller. Well driller deceased

11. **Infiltration Trench:** Covered or open .....

Dimensions: Length ..... ft. Minimum depth ..... ft. Maximum depth ..... ft.

Bottom width ..... ft. Discharge ..... g.p.m. Date of test .....

12. **Tunnel:** Type of lining .....

Dimensions: .....
(Length, course, and cross sectional size)

Position of water bearing stratum with reference to portal of tunnel .....

Log of tunnel: (Preceding table for log of well may be used, if desired. Give footage from portal and character of materials, as pertinent.)

13. **Pumping Equipment:**

(a) Pump Myers pump - rod pump - 9" stroke (Make, type and size) capacity 6 g.p.m.

(b) Motor 2HP Century Electric Motor (Type and horsepower)

14. Location of area irrigated or to be irrigated, or place of use if for purposes other than irrigation.

| Township North or South | Range E. or W. of Willamette Meridian | Section | Forty-acre Tract | Number Acres To Be Irrigated | Date of Reclamation |
|---|---|---|---|---|---|
| 2N | 2W | 33 | SW 1/4 of NE 1/4 | 2.0 | 1932 |
| | | | | | |
| | | | | | |
15. If the ground water supply is supplemental to an existing water supply, identification of any application for a permit, permit, certificate or adjudicated right to appropriate water made or held by the registrant.

.....

.....

GR 1914

Township 2N Range 2W, W.M.

North

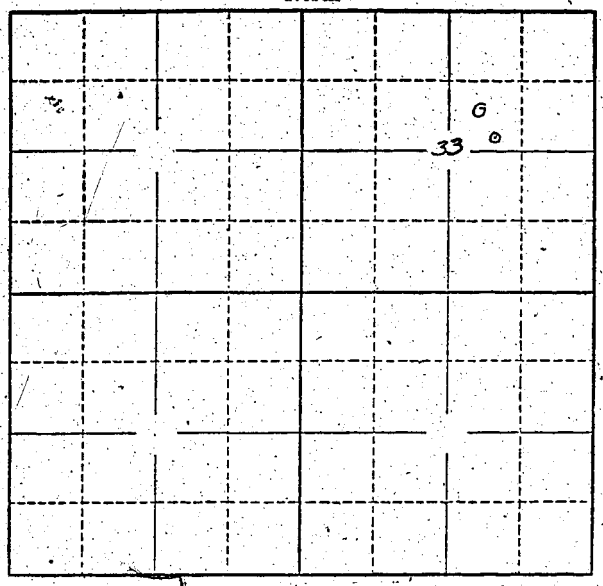


Locate well and acreage of irrigated land on plat.

Scale: 2" — 1 Mile

STATE OF OREGON
County of Marion } ss.

I, K Henry Brandt, being first duly sworn, do hereby certify that I have read the foregoing Registration Statement and that all of the items therein contained are true to the best of my knowledge and belief.

K Henry Brandt
(Signature of Registrant)

Subscribed and sworn to before me this 7th day of July, 19 58

My commission expires 12th June 1961 Wm. S. Bartholomew
(Notary Public)

(SEAL)

## CERTIFICATE OF REGISTRATION

STATE OF OREGON
County of Marion } ss.

This is to certify that the foregoing Registration Statement was received in the office of the State Engineer on the 9th day of July, 19 58, at ..... o'clock ..... M. and has been duly recorded in said office in Book No. 9 of Registration Statements on page GR-1914

Witness my hand this 9th day of February, 19 59

Lewis A. Stevens
(State Engineer)

By .....
(Deputy)

$15.00

GR-1914