

RECEIVED  
JUL 9 1958  
STATE ENGINEER  
SALEM, OREGON

Registration No. GR - 1986  
Certificate No. GR - 1917

# Registration Statement

## OF CLAIMANT OF RIGHT TO APPROPRIATE GROUND WATER

TO THE STATE ENGINEER OF OREGON:

I, Carl R. Lamb  
of Route 1, Box 472, Clackamas County of Clackamas  
(Mailing address)

State of Oregon do hereby make application for a certificate of registration as evidence of a right to appropriate ground water.

1. Source from which water is withdrawn is pump well  
(Flowing well, pump well, infiltration trench, or tunnel)

2. Location is: West 4th Ave., between Clackamas Road and St. Helena St.  
(Approximate distance and direction from nearest city or town)

and is more particularly described as follows:

(a) 16.5 feet south of 1020 feet east from W 1/4 corner Section 9  
(Give distance and bearing to corner of section or other legal subdivision)

being within NW 1/4 of SW 1/4 of Sec. 19, Twp. 2 S, Rge. 2 E  
(Smallest legal subdivision) (N. or S.) (E. or W.)

or (b) within limits of recorded platted property, town or city:

in Lot 9, Block 21 of Roads Addition to Mansfield  
(Name of plat or addition)

County of Clackamas  
(If within city or town, give name)

3. Construction Work was begun on 1940; was completed on Dec. 14, 1940  
(Date) (Date)

and the ground water claimed was first used for the purposes set out below on Jan. 1941  
(Date)

since which time the water has been used continuously  
(Continuously or intermittently)

from Jan. 1941 to July 1958  
(Date) (Date)

4. Quantity of water claimed and used is 400 gallons per minute;        acre feet per year.

5. Purpose or Purposes for which water is used irrigation  
(Domestic, irrigation, municipal, manufacturing, industrial, etc.)

6. Description of Well: Depth 30 feet. Type drilled  
(Dug or drilled)

diameter 6 inches. Elevation of ground at well site 500 ft feet, mean sea level.  
(As near as known)

Depth to water table 73 feet.

7. Capacity of Well: exceeds 400 g.p.m. with        feet drawdown.

       g.p.m. with        feet drawdown.

Date of test Dec. 14, 1940

If Flowing Well: Measured discharge        g.p.m. on         
(Date)

Shut-in pressure at ground surface        lbs. per sq. in. on         
(Date)

Water is controlled by         
(Cap, valve, etc.)

8. Casing: (Give diameter, commercial specifications and depth below ground surface of each casing size.)

6 inch diameter ..... from surface to 30 feet  
..... inch diameter ..... from ..... to ..... feet  
..... inch diameter ..... from ..... to ..... feet  
..... inch diameter ..... from ..... to ..... feet

Describe and show depth of shoe, plug, adapter, liner or other details: shoe at 30 ft.

9. Perforated Casings or Screens:

3/16" - 4 to a foot ..... from 71 to 31  
(Number per foot and size of perforations, or describe screen)  
..... from ..... to .....  
..... from ..... to .....  
..... from ..... to .....

10. Log of Well: (Describe each stratum or formation clearly, indicate if water bearing, and give thickness and depth as indicated.)

MATERIAL	Thickness (Feet)	Depth to Bottom (Feet)
20 feet top soil		
Top soil	20	
sand & gravel	60	

If log of well is not available, give name and address of driller.

O. E. Janssen, Clackamas, Oregon

11. Infiltration Trench: Covered or open

Dimensions: Length ft. Minimum depth ft. Maximum depth ft. Bottom width ft. Discharge g.p.m. Date of test

12. Tunnel: Type of lining

Dimensions: (Length, course, and cross sectional size) Position of water bearing stratum with reference to portal of tunnel

Log of tunnel: (Preceding table for log of well may be used, if desired. Give footage from portal and character of materials, as pertinent.)

13. Pumping Equipment:

(a) Pump Fairbanks Morse - jet Capacity 600 g.p.m. (b) Motor 1 HP


14. Location of area irrigated or to be irrigated, or place of use if for purposes other than irrigation.

Table with 6 columns: Township North or South, Range E. or W. of Williams' Meridian, Section, Forty-acre Tract, Number Acres To Be Irrigated, Date of Reclamation. Row 1: 2 S, 2 E, 9, Valley of Swley, 30, 1941

15. If the ground water supply is supplemental to an existing water supply, identification of any application for a permit, permit, certificate or adjudicated right to appropriate water made or held by the registrant.

Township 2 S Range 2 E, W.M.

North

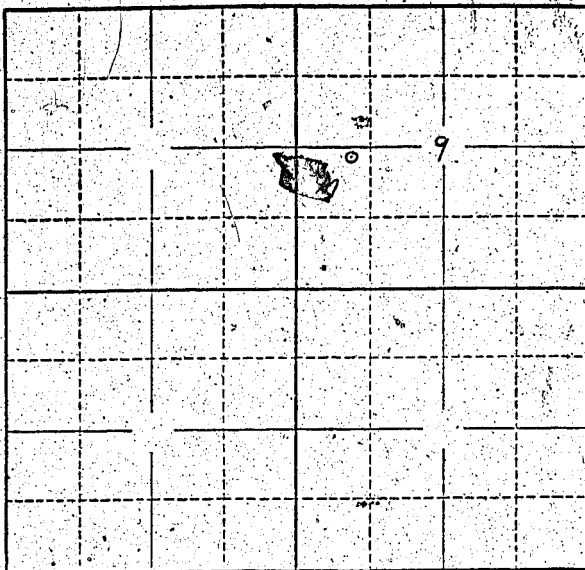

Locate well and acreage of irrigated land on plat.

Scale: 2" = 1 Mile

STATE OF OREGON

County of Clatsop

} ss.

I, Carl E. Lamp, being first duly sworn, do hereby certify that I have read the foregoing Registration Statement and that all of the items therein contained are true to the best of my knowledge and belief.

*Carl E. Lamp*  
(Signature of Registrant)

Subscribed and sworn to before me this 7 day of July, 1930.

My commission expires 3/9/32

(Notary Public)

(SEAL)

**CERTIFICATE OF REGISTRATION**

STATE OF OREGON

County of Marion

} ss.

This is to certify that the foregoing Registration Statement was received in the office of the State Engineer on the 9th day of July, 1930, at 6:00 o'clock A.M. and has been duly recorded in said office in Book No. 9 of Registration Statements on page GR-1917

Witness my hand this 9th day of February, 1930.

*Lewis A. Stankus*  
(State Engineer)

By \_\_\_\_\_ (Deputy)

\$15.00

GR-1917