

RECEIVED

JUN 19 1958

STATE ENGINEER

SALEM, OREGON

JUN 17 1958

STATE ENGINEER

SALEM, OREGON

REGISTRATION NO. GR-1991

Registration Statement

CERTIFICATE NO. GR-3869

OF CLAIMANT OF RIGHT TO APPROPRIATE GROUND WATER

(Under Chapter 708, Oregon Laws 1955.)

TO THE STATE ENGINEER OF OREGON:

I, Fred T. Heiman,

of Portland, County of Multnomah,

State of Oregon, do hereby make application for a certificate of registration as evidence of a right to appropriate ground water.

1. Source from which water is withdrawn is dump well.
(Flowing well, pump well, infiltration trench, or tunnel)
2. Location is: East of 11321 SE Glenwood Street, about 1/2 mile from Portland, Oregon;
(Approximate distance and direction from nearest city or town)

and is more particularly described as follows: (See blue dot in red area on back).

(a) Tax Lot 2, commencing at SE corner of West Half of NE 1/4

(Give distance and bearing to corner of section or other legal subdivision)

being within NE 1/4 of NE 1/4 of Sec. 22, Twp. 1 South, Rge. 2 East,
(smallest legal subdivision) (N. or S.) (E. or W.)

(approximately 31.15 acres shown in red on back);

or (b) within limits of recorded platted property, town or city:

in Lot _____, Block _____ of _____
(Name of plat or addition)

County of Multnomah;

(If within city or town, give name)

3. Construction Work was begun on May 1950, was completed on June 1950
(Date) (Date)

and the ground water claimed was first used for the purposes set out below on June 1950
(Date)

since which time the water has been used intermittently.
(Continuously or intermittently)

from June 1950 to April 7, 1958.
(Date) (Date)

4. Quantity of water claimed and used is 280 gallons per minute; 31.15 acre feet per year.

5. Purpose or Purposes for which water is used irrigation.

(Domestic, irrigation, municipal, manufacturing, industrial, etc.)

6. Description of Well: Depth 170 feet. Type Drilled

(Dug or drilled)

diameter 12 inches. Elevation of ground at well site 100 feet, mean sea level.
(As near as known)

Depth to water table 70 feet.

7. Capacity of Well: 280 g.p.m. with 100 feet drawdown.

_____ g.p.m. with _____ feet drawdown.

Date of test June 1950

If Flowing Well: Measured discharge _____ g.p.m. on _____
(Date)

Shut-in pressure at ground surface _____ lbs. per sq. in. on _____
(Date)

Water is controlled by _____
(Cup, valve, etc.)

8. Casing: (Give diameter, commercial specifications and depth below ground surface of each casing size.)

12 inch diameter from top to 170 feet
..... inch diameter from to feet
..... inch diameter from to feet
..... inch diameter from to feet

Describe and show depth of shoe, plug, adapter, liner or other details:

9. Perforated Casings or Screens:

..... 90 feet from surface to
(Number per foot and size of perforations, or describe screen)
..... from to
..... from to
..... from to

10. Log of Well: (Describe each stratum or formation clearly, indicate if water bearing, and give thickness and depth as indicated.)

MATERIAL	Thickness (Feet)	Depth to Bottom (Feet)
Top soil.	5 feet	
Gravel.	15 feet	
Depth at bottom.		

If log of well is not available, give name and address of driller.

11. Infiltration Trench: Covered or open Covered.

Dimensions: Length ft. Minimum depth ft. Maximum depth ft.

Bottom width ft. Discharge g.p.m. Date of test

12. Tunnel: Type of lining

Dimensions:
(Length, course, and cross sectional size)

Position of water bearing stratum with reference to portal of tunnel

Log of tunnel: (Preceding table for log of well may be used, if desired. Give footage from portal and character of materials, as pertinent.)

13. Pumping Equipment:

(a) Pump Fairbanks Morse (Make, type and size) Capacity 280 g.p.m.


(b) Motor 3 phase, 60 cycle, 220 volt, 25 h.p. (Type and horsepower)

14. Location of area irrigated or to be irrigated, or place of use if for purposes other than irrigation.

Township North or South	Range E. or W. of Willamette Meridian	Section	Forty-acre Tract	Number Acres To Be Irrigated	Date of Reclamation
1 South	2 East	22	SW $\frac{1}{4}$ of NE $\frac{1}{4}$	31.15	1950

15. If the ground water supply is supplemental to an existing water supply, identification of any application for a permit, permit, certificate or adjudicated right to appropriate water made or held by the registrant.

Township 15 Range 2E W.M.
North

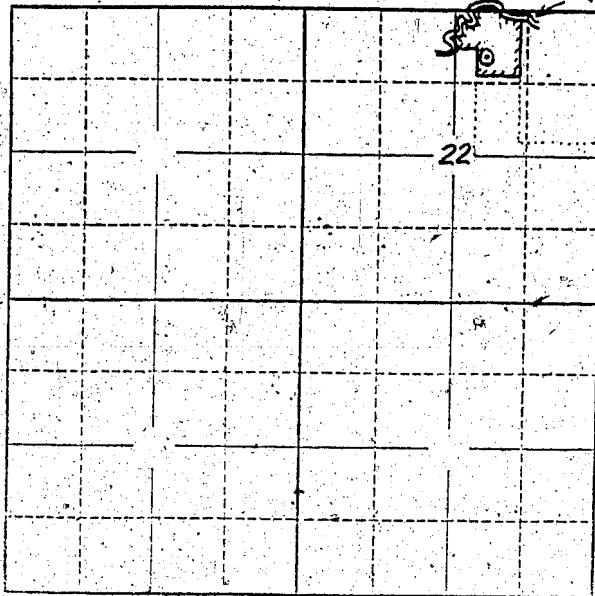

Locate well and acreage of irrigated land on plat.

Scale: 2" = 1 Mile

(Acreage shown in red being northern portion of property; and approximate location of well indicated by blue dot.)

STATE OF OREGON

County of Multnomah } ss.

Fred T. Heiman, being first duly sworn, do hereby certify that I have read the foregoing Registration Statement and that all of the items therein contained are true to the best of my knowledge and belief.

Fred T. Heiman
(Signature of Registrant)

Subscribed and sworn to before me this 7th day of April, 19 58.

My commission expires September 3, 1959.

[Signature]
(Notary Public)

(SEAL)

CERTIFICATE OF REGISTRATION

STATE OF OREGON

County of Marion } ss.

This is to certify that the foregoing Registration Statement was received in the office of the State Engineer on the 9th day of July, 19 58, at 1:00 o'clock P.M. and has been duly recorded in said office in Book No. 16 of Registration Statements on page GR 3869

~~Construction shall be completed by _____, 19____ and the water completely applied to beneficial use by _____, 19____.~~

Witness my hand this 28th day of December, 19 59.

Lewis A. Stanley
(State Engineer)

By _____ (Deputy)

GR-3869

\$15.30