

# Registration Statement

## OF CLAIMANT OF RIGHT TO APPROPRIATE GROUND WATER

TO THE STATE ENGINEER OF OREGON:

I, I.R. & Carrie L. Hammer  
of Rt 1 Box 100 Aumsville Ore County of Marion  
(Mailing address)  
State of ORE, do hereby make application for a certificate of registration as evidence of a right to appropriate ground water.

1. Source from which water is withdrawn is Well  
(Flowing well, pump well, infiltration trench, or tunnel)

2. Location is: 1 mi. South of West Stayton  
(Approximate distance and direction from nearest city or town)

and is more particularly described as follows:

(a) 462' E and 528 N of the West 1/4 corner Sec 19  
(Give distance and bearing to corner of section or other legal subdivision)

being within SW/NW of Sec. 19, Twp. 9S, Rge. 1W  
(Smallest legal subdivision) (N. or S.) (E. or W.)

or (b) within limits of recorded platted property, town or city:

in Lot \_\_\_\_\_, Block \_\_\_\_\_ of \_\_\_\_\_  
(Name of plat or addition)  
County of \_\_\_\_\_  
(If within city or town, give name)

3. Construction Work was begun on 1954; was completed on 1954  
(Date) (Date)

and the ground water claimed was first used for the purposes set out below on 1954-55  
(Date)

since which time the water has been used Intermittently  
(Continuously or intermittently)

from 1954 to 1957  
(Date) (Date)

4. Quantity of water claimed and used is 180 gallons per minute; 25 acre feet per year.

5. Purpose or Purposes for which water is used Irrigation  
(Domestic, irrigation, municipal, manufacturing, industrial, etc.)

6. Description of Well: Depth 20.0 feet. Type ~~DRILLED~~ DRILLED  
(Dug or drilled)

diameter 8 inches. Elevation of ground at well site 370 feet, mean sea level.  
(As near as known)

Depth to water table 6-8 feet.

7. Capacity of Well: 180 g.p.m. with 0 feet drawdown  
\_\_\_\_\_ g.p.m. with \_\_\_\_\_ feet drawdown.

Date of test during Irrigation

If Flowing Well: Measured discharge \_\_\_\_\_ g.p.m. on \_\_\_\_\_  
(Date)


Shut-in pressure at ground surface \_\_\_\_\_ lbs. per sq. in. on \_\_\_\_\_  
(Date)

Water is controlled by \_\_\_\_\_  
(Cap. valve, etc.)





Township 9 S Range 1 W W.M.  
North

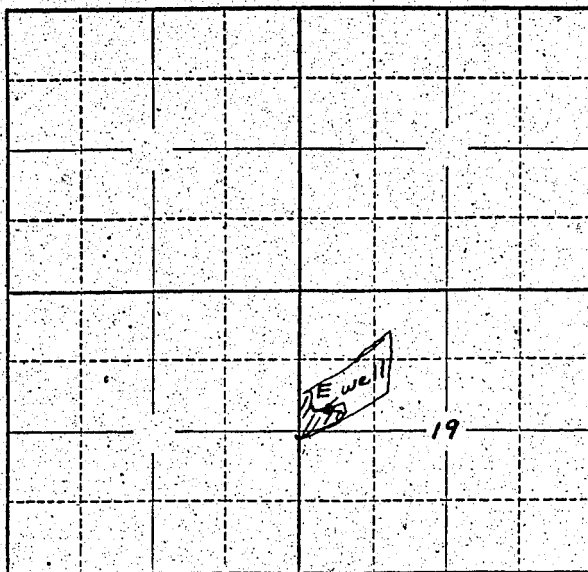

Locate well and acreage of irrigated land on plat.  
Scale: 2" = 1 Mile

STATE OF OREGON

County of Marion } ss.

I, Ernie Lee Hammer, being first duly sworn, do hereby certify that I have read the foregoing Registration Statement and that all of the items therein contained are true to the best of my knowledge and belief.

Ernie Lee Hammer  
(Signature of Registrant)

Subscribed and sworn to before me this 7 day of \_\_\_\_\_, 19\_\_.

My commission expires Jan 19 1933  
(Notary Public)

(SEAL)

**CERTIFICATE OF REGISTRATION**

STATE OF OREGON

County of Marion } ss.

This is to certify that the foregoing Registration Statement was received in the office of the State Engineer on the 9th day of June, 1958, at 1:00 o'clock P.M. and has been duly recorded in said office in Book No. 9 of Registration Statements on page GR-1922

Witness my hand this 9th day of February, 1959

Clara A. Stanley  
(State Engineer)

\$15.00

By \_\_\_\_\_  
(Deputy)