

Registration Statement

OF CLAIMANT OF RIGHT TO APPROPRIATE GROUND WATER

TO THE STATE ENGINEER OF OREGON:

I, R. A. & V. B. Hammer
of Rt Box 101 Aumsville County of Marion
(Mailing address)

State of Oregon, do hereby make application for a certificate of registration as evidence of a right to appropriate ground water.

1. Source from which water is withdrawn is Pump well
(Flowing well, pump well, infiltration trench or tunnel)

2. Location is: 1 mile south of West Stanton
(Approximate distance and direction from nearest city or town)

and is more particularly described as follows: Wells 990 ft East and 429

(a) ft South from 1/4 corner on West line Sec 19-T9S-R1W
(Give distance and bearing to corner of section or other legal subdivision)

being within NW 1 SW of Sec. 19, Twp. 9, Rge. 1 W
(Smallest legal subdivision) (N. or S.) (E. or W.)

or (b) within limits of recorded platted property, town, or city:

in Lot _____, Block _____ of _____
(Name of plat or addition)

County of _____
(If within city or town, give name)

3. Construction Work was begun on April 1951; was completed on April 1951
(Date) (Date)

and the ground water claimed was first used for the purposes set out below on April 1951
(Date)

since which time the water has been used _____
(Continuously or Intermittently)

from April 1951 to Sept 1957
(Date) (Date)

4. Quantity of water claimed and used is 424 gallons per minute; 57.5 acre feet per year.

5. Purpose or Purposes for which water is used Irrigation
(Domestic, irrigation, municipal, manufacturing, industrial, etc.)

6. Description of Well: Depth 19 feet. Type drilled
(Dug or drilled)

diameter 8 inches. Elevation of ground at well site 365 feet, mean sea level.
(As near as known)

Depth to water table 8 feet.

7. Capacity of Well: 550 g.p.m. with 3 feet drawdown. April 1951

450 g.p.m. with 1.2 feet drawdown. August 1957

Date of test April 1957

If Flowing Well: Measured discharge _____ g.p.m. on _____
(Date)

Shut-in pressure at ground surface _____ lbs. per sq. in. on _____
(Date)

Water is controlled by _____
(Cap, valve, etc.)

8. Casing: (Give diameter, commercial specifications and depth below ground surface of each casing size.)

8 inch diameter *steel well casing* from 0 to 19 feet
inch diameter from to feet
inch diameter from to feet
inch diameter from to feet

Describe and show depth of shoe, plug, adapter, liner or other details:

9. Perforated Casings or Screens:

1" x 6" slots 9/ft for 10 ft from 9 to 19 ft
(Number per foot and size of perforations, or describe screen)
from to
from to
from to

10. Log of Well: (Describe each stratum or formation clearly, indicate if water bearing, and give thickness and depth as indicated.)

MATERIAL	Thickness (Feet)	Depth to Bottom (Feet)
<i>Sand some dirt</i>	<i>6</i>	<i>6</i>
<i>Sand & small gravel</i>	<i>6</i>	<i>12</i>
<i>Blue Clay</i>	<i>1 1/2</i>	<i>13 1/2</i>
<i>Gravel & some sand</i>	<i>5 1/2</i>	<i>19</i>

If log of well is not available, give name and address of driller. *West - Salem, Ore.*

11. Infiltration Trench: Covered or open

Dimensions: Length ft. Minimum depth ft. Maximum depth ft.
 Bottom width ft. Discharge g.p.m. Date of test

12. Tunnel: Type of lining

Dimensions:
(Length, course, and cross sectional size)
 Position of water bearing stratum with reference to portal of tunnel

Log of tunnel: (Preceding table for log of well may be used, if desired. Give footage from portal and character of materials, as pertinent.)

13. Pumping Equipment:


(a) Pump *Cornell centrifugal 3"* Capacity *424* g.p.m.
(Make, type and size)
 (b) Motor *Westinghouse 15HP electric*
(Type and horsepower)

14. Location of area irrigated or to be irrigated, or place of use if for purposes other than irrigation.

Township North or South	Range E. or W. of Willamette Meridian	Section	Forty-acre Tract	Number Acres To Be Irrigated	Date of Reclamation
<i>9 S</i>	<i>1 W</i>	<i>19</i>	<i>SW/NW</i>	<i>3.9</i>	<i>Apr 1951</i>
"	"	"	<i>SE/NW</i>	<i>2.2</i>	"
"	"	"	<i>NW/SW</i>	<i>16.3</i>	"
"	"	"	<i>NE/SW</i>	<i>1.2</i>	"
				<i>28.6</i>	

15. If the ground water supply is supplemental to an existing water supply, identification of any application for a permit, permit, certificate or adjudicated right to appropriate water made or held by the registrant.

Township 9 S Range 1 W W.M.
North

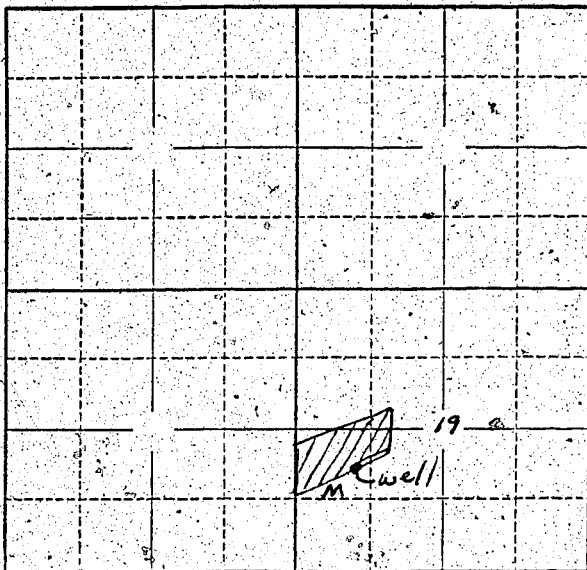

Locate well and acreage of irrigated land on plat.

Scale: 2" = 1 Mile

STATE OF OREGON

County of Marion } ss.

I, R. A. Hammer, being first duly sworn, do hereby certify that I have read the foregoing Registration Statement and that all of the items therein contained are true to the best of my knowledge and belief.

R. A. Hammer

(Signature of Registrant)

Subscribed and sworn to before me this 22 day of Nov, 1958

My commission expires _____

[Signature]
(Notary Public)

(SEAL)

CERTIFICATE OF REGISTRATION

STATE OF OREGON

County of Marion } ss.

This is to certify that the foregoing Registration Statement was received in the office of the State Engineer on the 9th day of June, 1958, at 1:00 o'clock P. M. and has been duly recorded in said office in Book No. 9 of Registration Statements on page 1923

Witness my hand this 9th day of February, 1959

[Signature]
(State Engineer)

By _____
(Deputy)

\$15.00