

Registration Statement

OF CLAIMANT OF RIGHT TO APPROPRIATE GROUND WATER

TO THE STATE ENGINEER OF OREGON:

I, Ralph Racette
of Aurora, Rt. 2 Box 177 County of Marion
(Mailing address)

State of Oregon do hereby make application for a certificate of registration as evidence of a right to appropriate ground water.

1. Source from which water is withdrawn is Pump Well
(Flowing well, pump well, infiltration trench, or tunnel)

2. Location is: 4 1/2 miles N. W. of Aurora, Oregon
(Approximate distance and direction from nearest city or town)

and is more particularly described as follows:

(a) Well is 462 ft. South & 158 ft. West of N. E. corner Sec. 8
(Give distance and bearing to corner of section or other legal subdivision)
being within N. E. 1/4 of N. E. 1/4 of Sec. 8, Twp. 4 S., Rge. 1 W.
(Smallest legal subdivision) (N. or S.) (E. or W.)

or (b) within limits of recorded platted property, town or city:
in Lot _____, Block _____ of _____
(Name of plat or addition)

County of Marion
(If within city or town, give name)

3. Construction Work was begun on August 5, 1949; was completed on August 20, 1949
(Date) (Date)

and the ground water claimed was first used for the purposes set out below on August 20, 1949
(Date)

since which time the water has been used Intermittently
(Continuously or Intermittently)

from May 1 to October 1
(Date) (Date)

4. Quantity of water claimed and used is 200 gallons per minute; 70 acre feet per year.

5. Purpose or Purposes for which water is used Irrigation

(Domestic, irrigation, municipal, manufacturing, industrial, etc.)

6. Description of Well: Depth 110 feet Type Drilled (Cable Tools)
(Dug or drilled)

diameter 8 inches. Elevation of ground at well site 180 feet, mean sea level.
(As near as known)

Depth to water table unk. feet.

7. Capacity of Well: No. Test g.p.m. with _____ feet drawdown.
_____ g.p.m. with _____ feet drawdown.

Date of test _____

If Flowing Well: Measured discharge _____ g.p.m. on _____
(Date)

Shut-in pressure at ground surface _____ lbs. per sq. in. on _____
(Date)

Water is controlled by _____
(C&P, valve, etc.)

8. Casing: (Give diameter, commercial specifications and depth below ground surface of each casing size.)

8 inch diameter Steel casing from top to 86 feet
 inch diameter from to feet
 inch diameter from to feet
 inch diameter from to feet

Describe and show depth of shoe, plug, adapter, liner or other details:

8" Coupler Welded on for Shoe

9. Perforated Casings or Screens:

8 Torch perforations from 52 to 54
(Number per foot and size of perforations, or describe screen)
 from to
 from to
 from to

10. Log of Well: (Describe each stratum or formation clearly, indicate if water bearing, and give thickness and depth as indicated.)

| MATERIAL | Thickness (Feet) | Depth to Bottom (Feet) |
|---------------------|------------------|------------------------|
| Top Soil | 0 | 3 ft. |
| Yellow Silt | 3 | 18 |
| Yellow Clay | 18 | 32 |
| Blue Clay | 32 | 52 |
| Black Sand (Water) | 52 | 54 |
| Blue Clay | 54 | 84 |
| Black Sand (Water) | 84 | 86 |
| Blue Clay No Casing | 86 | 110 |
| | | |
| | | |
If log of well is not available, give name and address of driller.....

Roy Perkins Rt. 2 Box 315 Salem, Oregon.....

11. Infiltration Trench: Covered or open

Dimensions: Length ft. Minimum depth ft. Maximum depth ft.

Bottom width ft. Discharge g.p.m. Date of test

12. Tunnel: Type of lining

Dimensions:
(Length, course, and cross sectional size)

Position of water bearing stratum with reference to portal of tunnel.....

Log of tunnel: (Preceding table for log of well may be used, if desired. Give footage from portal and character of materials, as pertinent.)

13. Pumping Equipment:

(a) Pump: Peerless Turbine Capacity 260 g.p.m.
(Make, type and size)


(b) Motor: 15 HP 3 phase
(Type and horsepower)

14. Location of area irrigated or to be irrigated, or place of use if for purposes other than irrigation.

| Township North or South | Range E. or W. of Willamette Meridian | Section | Forty-acre Tract | Number Acres To Be Irrigated | Date of Reclamation |
|-------------------------|---------------------------------------|---------|---|------------------------------|---------------------|
| 4S | 1W | 4 | SW ¹ / ₄ SW ¹ / ₄ | 3 | 1940 |
| " | " | 5 | SE ¹ / ₄ SE ¹ / ₄ | 3 | 1940 |
| " | " | 8 | NE ¹ / ₄ NE ¹ / ₄ | 16 | 1940 |
| " | " | 9 | NW ¹ / ₄ NW ¹ / ₄ | 16 | 1940 |
| | | | | Total 38 Acres | |
| | | | | | |
| | | | | | |
15. If the ground water supply is supplemental to an existing water supply, identification of any application for a permit, permit, certificate or adjudicated right to appropriate water made or held by the registrant.
None

Township 4S Range 1W, W.M.
North

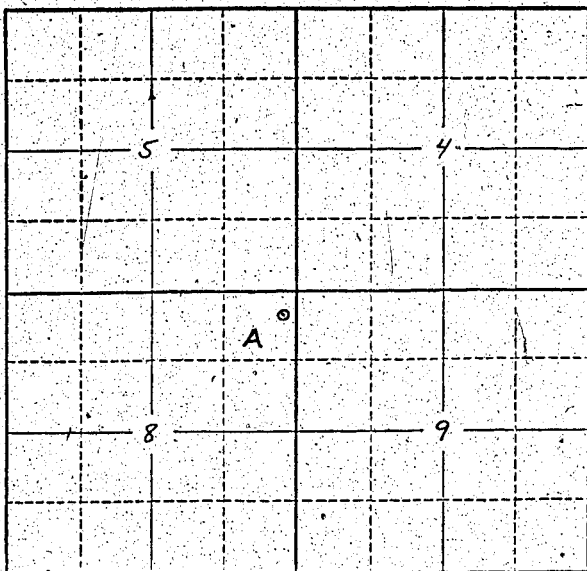

Locate well and acreage of irrigated land on plat.

Scale: 2" = 1 Mile

STATE OF OREGON

County of Marion

} ss.

I, Ralph Pacetto, being first duly sworn, do hereby certify that I have read the foregoing Registration Statement and that all of the items therein contained are true to the best of my knowledge and belief.

Ralph Pacetto
(Signature of Registrant)

Subscribed and sworn to before me this 10th day of July, 1958

My commission expires 12th June 1961

W.S. Bartholomew
(Notary Public)

(SEAL)

CERTIFICATE OF REGISTRATION

STATE OF OREGON

County of Marion

} ss.

This is to certify that the foregoing Registration Statement was received in the office of the State Engineer on the 10th day of July, 1958, at 10⁰⁰ o'clock A. M. and has been duly recorded in said office in Book No. 9 of Registration Statements on page GR-1929

Witness my hand this 9th day of February

Laura A. Stanley
(State Engineer)

By

(Deputy)

GR-1929

#1620