

RECEIVED  
AUG 24 1951  
STATE ENGINEER  
SALEM, OREGON

REGISTRATION NO. GR-2  
CERTIFICATE NO. GR-77

### Registration Statement

#### OF CLAIMANT OF RIGHT TO APPROPRIATE GROUND WATER

(Under Chapter 708, Oregon Laws 1955.)

TO THE STATE ENGINEER OF OREGON:

I, W. Earl Dunn

of Woodburn County of Marion

State of Oregon, do hereby make application for a certificate of registration as evidence of a right to appropriate ground water.

1. Source from which water is withdrawn is Pump well  
(Flowing well, pump well, infiltration trench, or tunnel)

2. Location is: 3 1/2 miles East of Woodburn  
(Approximate distance and direction from nearest city or town)

and is more particularly described as follows:

I am enclosing legal description of farm and well is about in the  
(a) center of farm 30 chains North and 34 chains West of SE corner Sec. 15  
(Give distance and bearing to corner of section or other legal subdivision)

being within NW 1/4 of SE 1/4 of Sec. 15, Twp. 5 S, Rge. 1 W  
(Smallest legal subdivision) (N. or S.) (E. or W.)

or (b) within limits of recorded platted property, town or city:

in Lot \_\_\_\_\_ Block \_\_\_\_\_ of \_\_\_\_\_  
(Name of plat or addition)

County of \_\_\_\_\_  
(If within city or town, give name)

3. Construction Work was begun on About June 10 1951 was completed on June 23 1951  
(Date) (Date)

and the ground water claimed was first used for the purposes set out below on June 24th 1951  
(Date)

since which time the water has been used Continuously  
(Continuously or intermittently)

from April to October  
(Date) (Date)

4. Quantity of water claimed and used is 150 gallons per minute; \_\_\_\_\_ acre feet per year.

5. Purpose or Purposes for which water is used Irrigation

(Domestic, irrigation, municipal, manufacturing, industrial, etc.)

6. Description of Well: Depth 91 feet. Type Drilled  
(Dug or drilled)

diameter 10 inches. Elevation of ground at well site Think about 100 feet, mean sea level.  
(As near as known)

Depth to water table 1.25 feet.

7. Capacity of Well: 450 g.p.m. with 65 feet drawdown.

290 g.p.m. with 41 feet drawdown.  
200 g.p.m. with 31 feet drawdown.

Date of test June 23 1951

If Flowing Well: Measured discharge \_\_\_\_\_ g.p.m. on \_\_\_\_\_  
(Date)

Shut-in pressure at ground surface \_\_\_\_\_ lbs. per sq. in. on \_\_\_\_\_  
(Date)

Water is controlled by \_\_\_\_\_  
(Cap, Valve, etc.)

8. Casing: (Give diameter, commercial specifications and depth below ground surface of each casing size.)

10 inch diameter ..... from ..... to 91 feet  
 ..... inch diameter ..... from ..... to ..... feet  
 ..... inch diameter ..... from ..... to ..... feet  
 ..... inch diameter ..... from ..... to ..... feet

Describe and show depth of shoe, plug, adapter, liner or other details: .....

9. Perforated Casings or Screens:

*slots* ..... from 75' to 90'  
(Number per foot and size of perforations, or describe screen)  
 ..... from ..... to .....  
 ..... from ..... to .....  
 ..... from ..... to .....

10. Log of Well: (Describe each stratum or formation clearly, indicate if water bearing, and give thickness and depth as indicated.)

MATERIAL	Thickness (Feet)	Depth to Bottom (Feet)
<i>no record available</i>		

If log of well is not available, give name and address of driller: Fred Wymore Rt. 2, Salem, Oregon  
Phone No. 2-5135

11. Infiltration Trench: Covered or open .....  
 Dimensions: Length ..... ft. Minimum depth ..... ft. Maximum depth ..... ft.  
 Bottom width ..... ft. Discharge ..... g.p.m. Date of test .....

12. Tunnel: Type of lining .....  
 Dimensions: .....  
(Length, course, and cross sectional size)  
 Position of water bearing stratum with reference to portal of tunnel .....

Log of tunnel: (Preceding table for log of well may be used, if desired. Give footage from portal and character of materials, as pertinent.)


13. Pumping Equipment:  
 (a) Pump ..... Pacific Pump Co. .... Capacity ..... 175 ..... g.p.m.  
(Make, type and size)  
 (b) Motor ..... Westinghouse 7 1/2 H.P. 3 Phase .....  
(Type and horsepower)

14. Location of area irrigated or to be irrigated, or place of use if for purposes other than irrigation.

Township North or South	Range E. or W. of Willamette Meridian	Section	Forty-acre Tract	Number Acres To Be Irrigated	Date of Reclamation
75S	1 West	15		31 - total	June 24 1951
"	"	"	NW 1/4 of SE 1/4	20	"
"	"	"	SW 1/4 of SE 1/4	8	"
"	"	"	NE 1/4 of SW 1/4	3	"

15. If the ground water supply is supplemental to an existing water supply, identification of any application for a permit, permit, certificate or adjudicated right to appropriate water made or held by the registrant.

Township 5 S. Range 1 W.M.  
North

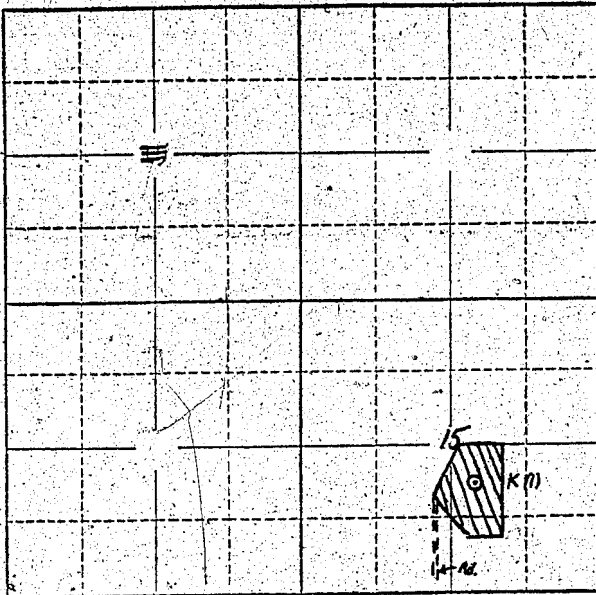

Locate well and acreage of irrigated land on plat.  
Scale: 2" = 1 Mile

STATE OF OREGON }  
County of Marion } ss.

I, W. Earl Dunn, being first duly sworn, do hereby certify that I have read the foregoing Registration Statement and that all of the items therein contained are true to the best of my knowledge and belief.

W. Earl Dunn  
(Signature of Registrant)

Subscribed and sworn to before me this 23rd day of August, 1955.

My commission expires May 24, 1959  
NOTARY PUBLIC FOR OREGON  
My Commission Expires May 24, 1959

[Signature]  
(Notary Public)

**CERTIFICATE OF REGISTRATION**

STATE OF OREGON }  
County of Marion } ss.

This is to certify that the foregoing Registration Statement was received in the office of the State Engineer on the 24th day of August, 1955, at 8:00 o'clock A. M. and has been duly recorded in said office in Book No. 1 of Registration Statements on page GR-77C.

~~Construction shall be completed by 1956 and the water completely applied to beneficial use by 1956.~~

Witness my hand this 12th day of April, 1956.

Lewis A. Stanley  
(State Engineer)

By \_\_\_\_\_ (Deputy)