

RECEIVED JUN 21 1956 STATE ENGINEER SALEM OREGON

REGISTRATION NO. GR-200  
CERTIFICATE NO. GR-186

# Registration Statement

## OF CLAIMANT OF RIGHT TO APPROPRIATE GROUND WATER

(Under Chapter 703, Oregon Laws 1955.)

TO THE STATE ENGINEER OF OREGON:

I, Roy F. Lofland and Maude Josephine Lofland  
Murphy Stage Road

of Grants Pass County of Josephine

State of Oregon, do hereby make application for a certificate of registration as evidence of a right to appropriate ground water.

1. Source from which water is withdrawn is Infiltration Trench, No. 1  
(Flowing well, pump well, infiltration trench, or tunnel)

2. Location is: 2 miles north and one-half mile east of Williams  
(Approximate distance and direction from nearest city or town)

and is more particularly described as follows:

(a) 1/4 - 498 feet West and 498 ft. North of the Southeast Corner of Sec. 14  
(Give distance and bearing to corner of section or other legal subdivision)

being within SE 1/4 SE 1/4 of Sec. 14 Twp. 38 S. Rge. 5 W.  
(Smallest legal subdivision) (N. or S.) (E. or W.)

or (b) within limits of recorded platted property, town or city:

in Lot \_\_\_\_\_, Block \_\_\_\_\_ of \_\_\_\_\_  
(Name of plat or addition)

(If within city or town, give name) County of Josephine

3. Construction Work was begun on Nov. 2, 1950; was completed on Nov. 10, 1950  
(Date) (Date)

and the ground water claimed was first used for the purposes set out below on June 15th, 1951  
(Date)

since which time the water has been used continuously each irrigation season  
(Continuously or intermittently)

from June 15th, 1951 to June 15, 1956  
(Date) (Date)

4. Quantity of water claimed and used is 480 gallons per minute; \_\_\_\_\_ acre feet per year.

5. Purpose or Purposes for which water is used Irrigating farm crops.

(Domestic irrigation, municipal, manufacturing, industrial, etc.)

6. Description of Well: Depth \_\_\_\_\_ feet. Type \_\_\_\_\_  
(Dug or drilled)

diameter \_\_\_\_\_ inches. Elevation of ground at well site \_\_\_\_\_ feet, mean sea level.  
(As near as known)

Depth to water table \_\_\_\_\_ feet.

7. Capacity of Well: \_\_\_\_\_ g.p.m. with \_\_\_\_\_ feet drawdown.

\_\_\_\_\_ g.p.m. with \_\_\_\_\_ feet drawdown.

Date of test \_\_\_\_\_

If Flowing Well: Measured discharge \_\_\_\_\_ g.p.m. on \_\_\_\_\_  
(Date)

Shut-in pressure at ground surface \_\_\_\_\_ lbs. per sq. in. on \_\_\_\_\_  
(Date)

Water is controlled by \_\_\_\_\_  
(Cap, valve, etc.)



If log of well is not available, give name and address of driller. ....

11. Infiltration Trench: Covered or open open.

Dimensions: Length 300' ft. Minimum depth 10 ft. Maximum depth 15 ft.

Bottom width 35 ft. Discharge 480 g.p.m. Date of test June 14, 1956.

12. Tunnel: Type of lining .....

Dimensions: .....  
(Length, course, and cross sectional size)

Position of water bearing stratum with reference to portal of tunnel .....

Log of tunnel: (Preceding table for log of well may be used, if desired. Give footage from portal and character of materials, as pertinent.)

13. Pumping Equipment:

(a) Pump Fairbanks Morse - Centrifugal 5" Capacity 480 g.p.m.  
(Make, type and size)

(b) Motor 3 phase electric - 25 H.P.  
(Type and horsepower)

14. Location of area irrigated or to be irrigated, or place of use if for purposes other than irrigation.

Township North or South	Range E. or W. of Willamette Meridian	Section	Forty-acre Tract	Number Acres To Be Irrigated	Date of Reclamation
38 S.	5 W.	14	SE $\frac{1}{4}$ SE $\frac{1}{4}$	33	1950
38 S.	5 W.	23	NE $\frac{1}{4}$ NE $\frac{1}{4}$	40	1950
38 S.	5 W.	24	NW $\frac{1}{4}$ NW $\frac{1}{4}$	32	1950


Description of property: **PARCEL I:** All of that portion of the West half of the Northwest quarter of Section 24, Township 38 South, Range 5 West of the Willamette Meridian, Josephine County, Oregon, lying West of the right of way of the Williams Secondary Highway. Less and excepting a parcel of land containing 1 acre conveyed by C. W. Roberts and Artie L. Roberts, husband and wife, to the State of Oregon, by and through its State Highway Commission, being situated in the Southwest corner of the above described premises and being more particularly described in the conveyance recorded in Volume 89, page 389 of Deed Records, Josephine County, Oregon.

**PARCEL II:** The Southeast quarter of the Southeast quarter of Section 14; the East half of the Northeast quarter and lots 5 and 7 of Section 23, Township 38 South, Range 5 West of the Willamette Meridian, Josephine County, Oregon. Less and excepting a parcel of land conveyed by Ethangia Letteken, a widow, to the State of Oregon, by and through its State Highway Commission, being 30 feet on each side of the center line of the relocated Williams Highway; said center line being described as follows: Beginning at a point which is 90 feet South and 25 feet East of the East quarter corner of Section 23, in said Township and Range; thence South 29° 08' West, a distance of 206.8 feet; thence on the arc of a 572.96 foot curve right (the long chord of which curve bears South 37° 21' 45" West, 164.0 feet) a distance of 164.6 feet; thence South 45° 35' 30" West a distance of 846.8 feet; thence on the arc of a 636.62 foot radius curve left (the long chord of which curve bears South 29° 07' West 361.1 feet) a distance of 366.1 feet; thence South 12° 38' 30" West a distance of 31.7 feet to Engineer's Station 593.60.6 Also less and except: A part of Government Lot 7 in Section 23, Township 38 South, Range 5 West of the Willamette Meridian, described as follows: Beginning at a point 400 feet South of the Northeast corner of said Lot; thence West to the East right of way of Williams Highway; thence Southwesterly along said highway to the South line of said Lot; thence East along the South line of said lot to the Southeast corner of said Lot; thence North to the point of beginning, Josephine County, Oregon.

**PARCEL III:** A part of Gov. Lot 4 and John L. Powell DLC No. 40, described as follows: Beg. at the Southeast corner of the Southwest quarter of the Northeast  $\frac{1}{4}$  of Sec. 23, T. 38 S., R. 5 W., W.M., running thence N. 80 rods; thence West to the East line of the said DLC; thence N. to the NE corner of said DLC; thence West to a point which is 82 rods, more or less, N. and 40 rods W. of the point of beginning; thence S. 82 rods, more or less, to a point West of the point of beginning; thence East 40 rods to the point of beginning.

15. If the ground water supply is supplemental to an existing water supply, identification of any application for a permit, permit, certificate or adjudicated right to appropriate water made or held by the registrant.

Township 38 S Range 5 W, W.M.  
North

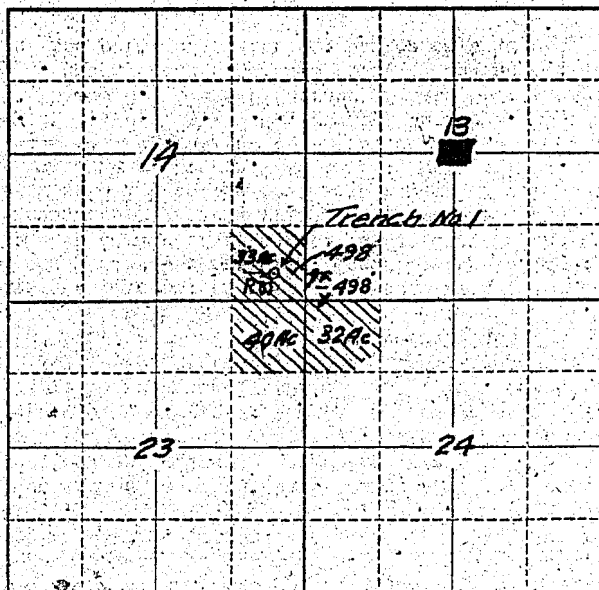

Locate well and acreage of irrigated land on plat.  
Scale: 2" = 1 Mile

STATE OF OREGON

County of Jackson

ss.

I. R. F. Lofland & Maude Josephine Lofland, being first duly sworn, do hereby certify that I have read the foregoing Registration Statement and that all of the items therein contained are true to the best of my knowledge and belief.

Roy F. Lofland  
Maude Josephine Lofland  
(Signature of Registrant)

Subscribed and sworn to before me this 19th day of June, 1956.

My commission expires Jan. 22, 1960

Cap. C. [Signature]  
(Notary Public)

(SEAL)

FOR CERTIFICATE OF REGISTRATION SEE PAGE GR-186 G  
CERTIFICATE OF REGISTRATION

STATE OF OREGON

County of Marion

ss.

~~This is to certify that the foregoing Registration Statement was received in the office of the State Engineer on the X-X-X day of X-X-X-X-X-X-X-X, 19X-X, at X-X-X-X-X-X-X-X. It has been duly recorded in said office in Book No. X-X-X-X-X-X of Registration Statements on page X-X-X-X-X-X. Construction shall be completed by X-X-X-X-X-X-X-X, 19X-X, and the water completely applied to beneficial use by X-X-X-X-X-X-X-X, 19X-X.~~

Witness my hand this \_\_\_\_\_ day of \_\_\_\_\_, 19\_\_\_\_.

(State Engineer)

By \_\_\_\_\_  
(Deputy)

GR-186 C

RECEIVED  
JUN 21 1956  
STATE ENGINEER  
SALEM OREGON

REGISTRATION NO. GR-200

Registration Statement CERTIFICATE NO. GR-186

OF CLAIMANT OF RIGHT TO APPROPRIATE GROUND WATER

(Under Chapter 708, Oregon Laws 1955.)

TO THE STATE ENGINEER OF OREGON:

I, Roy F. Lofland and Maude Josephine Lofland

Murphy Stage Road

of Grants Pass

County of Josephine

State of Oregon, do hereby make application for a certificate of registration as evidence of a right to appropriate ground water.

1. Source from which water is withdrawn is Infiltration trench No. 2  
(Flowing well, pump well, infiltration trench, or tunnel)

2. Location is: 2 miles North and one-half mile East of Williams  
(Approximate distance and direction from nearest city or town)

and is more particularly described as follows:

(a) 744 feet West and 198 ft. south of the Southeast corner of NE $\frac{1}{4}$  NE $\frac{1}{4}$  Sec. 23  
(Give distance and bearing to corner of section or other legal subdivision)

being within SE $\frac{1}{4}$  NE $\frac{1}{4}$  of Sec. 23, Twp. 38 S. Rge. 5 W.  
(Smallest legal subdivision) (N. or S.) (E. or W.)

or (b) within limits of recorded platted property, town or city:

in Lot \_\_\_\_\_, Block \_\_\_\_\_ of \_\_\_\_\_  
(Name of plat or addition)

County of Josephine  
(If within city or town, give name)

3. Construction Work was begun on Nov. 2, 1950; was completed on Nov. 10, 1950  
(Date) (Date)

and the ground water claimed was first used for the purposes set out below on June 15th, 1951  
(Date)

since which time the water has been used Continuously each irrigation season  
(Continuously or intermittently)

from June 15th, 1951 to June 15, 1956  
(Date) (Date)

4. Quantity of water claimed and used is 150 gallons per minute; \_\_\_\_\_ acre feet per year.

5. Purpose or Purposes for which water is used irrigating farm crops

(Domestic, irrigation, municipal, manufacturing, industrial, etc.)

6. Description of Well: Depth \_\_\_\_\_ feet. Type \_\_\_\_\_  
(Dug or drilled)

diameter \_\_\_\_\_ inches. Elevation of ground at well site \_\_\_\_\_ feet, mean sea level.  
(As near as known)

Depth to water table \_\_\_\_\_ feet.

7. Capacity of Well: \_\_\_\_\_ g.p.m. with \_\_\_\_\_ feet drawdown.

\_\_\_\_\_ g.p.m. with \_\_\_\_\_ feet drawdown.

Date of test \_\_\_\_\_

If Flowing Well: Measured discharge \_\_\_\_\_ g.p.m. on \_\_\_\_\_  
(Date)

Shut-in pressure at ground surface \_\_\_\_\_ lbs. per sq. in. on \_\_\_\_\_  
(Date)

Water is controlled by \_\_\_\_\_  
(Cap, valve, etc.)

GR-186 D





If log of well is not available, give name and address of driller. ....

11. Infiltration Trench: Covered or open open

Dimensions: Length 13 ft. Minimum depth 13 ft. Maximum depth 13 ft.

Bottom width 10 ft. Discharge 150 g.p.m. Date of test Jun 11, 1956

12. Tunnel: Type of lining .....

Dimensions: .....

(Length, course, and cross sectional size)

Position of water bearing stratum with reference to portal of tunnel .....

Log of tunnel: (Preceding table for log of well may be used, if desired. Give footage from portal and character of materials, as pertinent.)

13. Pumping Equipment:

(a) Pump Unknown - centrifugal 3" Capacity 150 g.p.m.

(Make, type and size)

(b) Motor farm tractor 40 H. P.

(Type and horsepower)


14. Location of area irrigated or to be irrigated, or place of use if for purposes other than irrigation.

Township North or South	Range E. or W. of Willamette Meridian	Section	Forty-acre Tract	Number Acres To Be Irrigated	Date of Reclamation
38 S.	5 W.	23	SE $\frac{1}{4}$ NE $\frac{1}{4}$	40	1950
38 S.	5 W.	23	SW $\frac{1}{4}$ NE $\frac{1}{4}$	18	1950
38 S.	5 W.	23	NW $\frac{1}{4}$ SE $\frac{1}{4}$	5	1950
38 S.	5 W.	23	NE $\frac{1}{4}$ SE $\frac{1}{4}$	7	1950
38 S.	5 W.	24	SW $\frac{1}{4}$ NW $\frac{1}{4}$	15	1950

Description of property: PARCEL I: All that portion of the West half of the NW quarter of Sec. 24, T. 38 S., R. 5 W., W.M., Josephine Co., Oregon, lying West of the right of way of the Williams Secondary Highway. Less and excepting a parcel of land containing 1 acre conveyed by C.W. Roberts and Artie L. Roberts, husband and wife, to the State of Oregon, by and through its State Highway Commission, being situated in the SW corner of the above described premises and being more particularly described in the conveyance recorded in Vol. 89, page 389 of Deed Records, Josephine Co., Oregon, PARCEL II: The SE  $\frac{1}{4}$  of the SE  $\frac{1}{4}$  of Sec. 14; the East  $\frac{1}{2}$  of the NE  $\frac{1}{4}$  and Lots 5 and 7 of Sec. 23, T. 38 S., R. 5 W. W.M., Josephine Co., Oregon. Less and excepting a parcel of land conveyed by Ethangia Lettcken, a widow, to the State of Oregon, by and through its State Highway Commission, being 30 feet on each side of the center line of the relocated Williams Highway; said center line being described as follows: Beginning at a point which is 90 feet South and 25 feet East of the East  $\frac{1}{4}$  corner of Sec. 23, in said Township and Range; thence South 29° 08' West, a distance of 206.8 feet; thence on the arc of a 572.96 foot curve right (the long chord of which curve bears S. 37° 21' 45" West, 164.0 feet) a distance of 164.6 feet; thence S. 45° 35' 30" West a distance of 846.8 feet; thence on the arc of a 636.62 foot radius curve left (the long chord of which curve bears S. 29° 07' West 361.1 feet) a distance of 366.1 feet; thence South 12° 38' 30" West a distance of 31.7 feet to Engineer's Station 593.60.6. Also less and except: A part of Gov. Lot 7 in Sec. 23, T. 38 S., R. 5 W., W.M., described as follows: Beginning at a point 400 feet South of the NE corner of said Lot; thence W. to the E. right of way of Williams Highway; thence Southwesterly along said highway to the S. line of said Lot; thence E. along the S. line of said Lot to the SE corner of said Lot; thence N. to the point of beginning, Josephine County, Ore. PARCEL III: A part of Gov. Lot 4 and John L. Powell DIC No. 40, described as follows: Beg. at the SE corner of the SW quarter of the NE quarter of Sec. 23, T. 38 S., R. 5 W., W.M., running thence N. 80 rods; thence West to the East line of the said DIC; thence N. to the NE corner of said DIC; thence West to a point which is 82 rods, more or less, N. and 40 rods W. of the point of beginning; thence S. 82 rods, more or less, to a point West of the point of beginning; thence East 40 rods to the point of beginning.

15. If the ground water supply is supplemental to an existing water supply, identification of any application for a permit, permit, certificate or adjudicated right to appropriate water made or held by the registrant.

Township 38 S Range 5 W, W.M.  
North

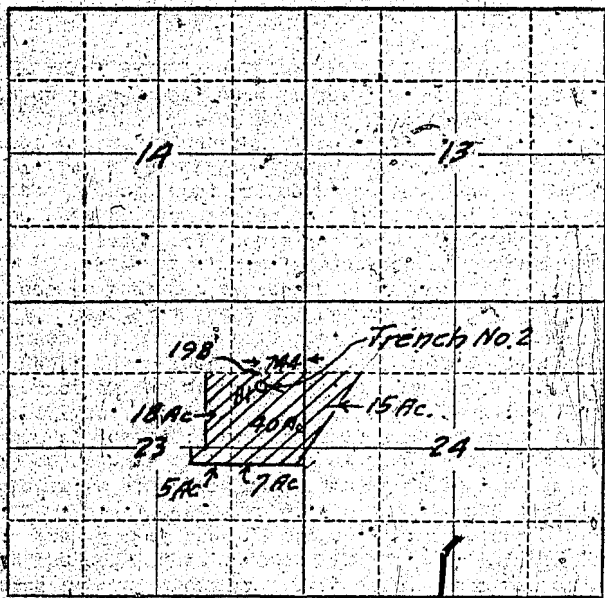

Locate well and acreage of irrigated land on plat.  
Scale:  $2'' = 1$  Mile

STATE OF OREGON

County of Jackson } ss.

I.R.F. Lofland & Maude Josephine Lofland, being first duly sworn, do hereby certify that I have read the foregoing Registration Statement and that all of the items therein contained are true to the best of my knowledge and belief.

R.F. Lofland  
Maude Josephine Lofland  
(Signature of Registrant)

Subscribed and sworn to before me this 19th day of June, 1956

My commission expires Jan. 22, 1960

Cap. E. Choudaquin  
(Notary Public)

(SEAL)

**CERTIFICATE OF REGISTRATION**

STATE OF OREGON

County of Marion } ss.

This is to certify that the foregoing Registration Statement was received in the office of the State Engineer on the 21st day of June, 1956, at 8 o'clock A. M. and has been duly recorded in said office in Book No. 1 of Registration Statements on page GR-186 G.

~~Construction shall be completed by x-x-x-x-x-x-x-19 and the water completely applied to beneficial use by x-x-x-x-x-x-x-19.~~

Witness my hand this \_\_\_\_\_ day of \_\_\_\_\_, 1956

Harro A. Stanley  
(State Engineer)

By \_\_\_\_\_  
(Deputy)

GR-186 G