

Registration Statement

OF CLAIMANT OF RIGHT TO APPROPRIATE GROUND WATER

(Under Chapter 708, Oregon Laws 1955.)

TO THE STATE ENGINEER OF OREGON:

I, Ray Stempley
of Woodburn, OR County of Marion
State of Oregon, do hereby make application for a certificate of registration as evidence of a right to appropriate ground water.

- 1. Source from which water is withdrawn is Pump Well
(Flowing well, pump well, infiltration trench, or tunnel)
- 2. Location is: 1 1/2 mi. west by north from Woodburn
(Approximate distance and direction from nearest city or town)

and is more particularly described as follows: 2600' E & 800' S. from NW Corner Sec. 12

(a) 1/4 mi. north on east side from highway over boundary line
(Give distance and bearing to corner of section or other legal subdivision)
being within NE 1/4 NW 1/4 of Sec. 12, Twp. 5 S, Rge. 2 W
(Smallest legal subdivision) (E or S) (E or W)
or (b) within limits of recorded platted property, town or city: Skellard grant
in Lot _____, Block _____ of _____
(Name of plat or addition)

County of _____
(If within city or town, give name)

3. Construction Work was begun on Dec. 1951; was completed on July 1952
(Date) (Date)
and the ground water claimed was first used for the purposes set out below on July 1952
(Date)
since which time the water has been used Intermittently
(Continuously or intermittently)
from July to September
(Date) (Date)

4. Quantity of water claimed and used is 160 gallons per minute; _____ acre feet per year.

5. Purpose or Purposes for which water is used Irrigation
Very small amount used for dust settling on road.
(Domestic, irrigation, municipal, manufacturing, industrial, etc.)

6. Description of Well: Depth 143 feet. Type Drilled
(Dug or drilled)
diameter 8 inches. Elevation of ground at well site 110 feet, mean sea level.
(As near as known)
Depth to water table 143-30 feet.

7. Capacity of Well: 388 g.p.m. with sustained feet drawdown.
_____ g.p.m. with _____ feet drawdown.


Date of test July 1952

If Flowing Well: Measured discharge _____ g.p.m. on _____
(Date)

Shut-in pressure at ground surface _____ lbs. per sq. in. on _____
(Date)

Water is controlled by _____
(Cap, valve, etc.)

Township 5 S Range 2 W W.M.
North

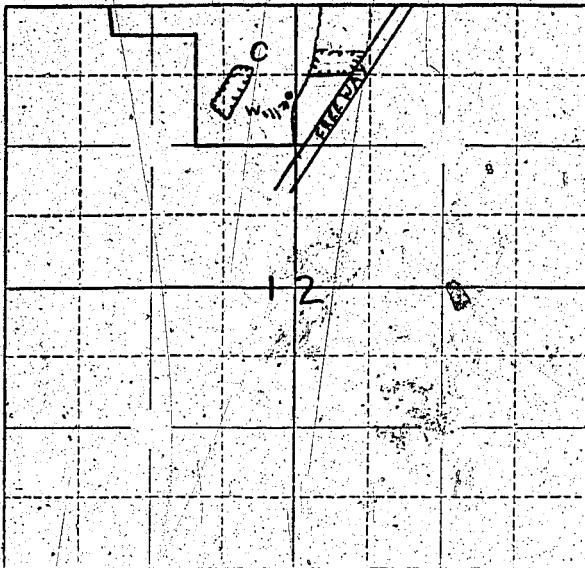

Locate well and acreage of irrigated land on plat.

Scale: $\frac{1}{4}$ " = 1 Mile

STATE OF OREGON

County of Marion

ss.

I, Ray Stampley, being first duly sworn, do hereby certify that I have read the foregoing Registration Statement and that all of the items therein contained are true to the best of my knowledge and belief.

Ray Stampley
(Signature of Registrant)

Subscribed and sworn to before me this 10th day of July, 1958

My commission expires 12th June 1961

Wm. S. Bartholomew
(Notary Public)

(SEAL)

CERTIFICATE OF REGISTRATION

STATE OF OREGON

County of Marion

ss.

This is to certify that the foregoing Registration Statement was received in the office of the State Engineer on the 10th day of June, 1958, at 12:00 o'clock A.M. and has been duly recorded in said office in Book No. 9 of Registration Statements on page GR-1931

~~Construction shall be completed by 1959 and the water completely applied to beneficial use by 1960~~

Witness my hand this 9th day of February, 1959

Laura A. ...
(State Engineer)

By

(Deputy)

GR-1931

\$1500