RECEIVED
JUL 10 1958
STATE ENGINEER
SALEM, OREGON

REGISTRATION NO. GR-2010
CERTIFICATE NO. GR- 1938

Registration Statement

OF CLAIMANT OF RIGHT TO APPROPRIATE GROUND WATER

(Under Chapter 708, Oregon Laws 1955.)

TO THE STATE ENGINEER OF OREGON:

I, Carl Russell and Winona I. Russell,

of Rt. # 2 Box 414 Hillsboro County of Washington

State of Oregon, do hereby make application for a certificate of registration as evidence of a right to appropriate ground water.

1. **Source** from which water is withdrawn is pump well (Flowing well, pump well, infiltration trench, or tunnel)

2. **Location** is: 1½ Miles west of Hillsboro. Oregon (Approximate distance and direction from nearest city or town);

and is more particularly described as follows: approx. 410 feet North & 310 feet east from S¼ corner Section 35.

(a) 170' East & 75'S of the N.W. Corner of Lot 24 (Give distance and bearing to corner of section or other legal subdivision)

being within S. W. ¼ of The S. E. ¼ (Smallest legal subdivision) of Sec. 35, Twp. 1 N (N. or S.), Rge. 3 W. WM. (E. or W.)

or (b) within limits of recorded platted property, town or city: West one half of

in Lot 24, Block ----- of Oak Park Addition (Name of plat or addition)

(If within city or town, give name) County of Washington

3. **Construction Work** was begun on 1954 (Date); was completed on 1954 (Date)

and the ground water claimed was first used for the purposes set out below on 1954 (Date),

since which time the water has been used continuously (Continuously or intermittently)

from 1954 (Date) to November 25, 1957 (Date)

4. **Quantity** of water claimed and used is 35 gallons per minute; two acre feet per year.

5. **Purpose or Purposes** for which water is used ~~Domestic and~~ Irrigation

(Domestic, irrigation, municipal, manufacturing, industrial, etc.)

6. **Description of Well:** Depth 68' feet. Type Drilled (Dug or drilled)

diameter six inches. Elevation of ground at well site (As near as known) feet, mean sea level.

Depth to water table 18 feet.

7. **Capacity of Well:** 35 g.p.m. with 16 feet drawdown.

g.p.m. with feet drawdown.

Date of test 1954

If Flowing Well: Measured discharge g.p.m. on (Date)

Shut-in pressure at ground surface lbs. per sq. in. on (Date)

Water is controlled by (Cap, valve, etc.)

8. **Casing:** (Give diameter, commercial specifications and depth below ground surface of each casing size.)

6 inch diameter steel casing from surface to 58 feet

..... inch diameter ..... from ..... to ..... feet

..... inch diameter ..... from ..... to ..... feet

..... inch diameter ..... from ..... to ..... feet

Describe and show depth of shoe, plug, adapter, liner or other details: .....

9. **Perforated Casings or Screens:**

No. ..... from ..... to .....
(Number per foot and size of perforations, or describe screen)

..... from ..... to .....

..... from ..... to .....

..... from ..... to .....

10. **Log of Well:** (Describe each stratum or formation clearly, indicate if water bearing, and give thickness and depth as indicated.)

MATERIAL	Thickness (Feet)	Depth to Bottom (Feet)
unknown		

GR-1938

If log of well is not available, give name and address of driller. J. H. O'Neel
431 South Ninth Street.
Hillsboro, Oregon

11. **Infiltration Trench:** Covered or open .....

Dimensions: Length ..... ft. Minimum depth ..... ft. Maximum depth ..... ft.

Bottom width ..... ft. Discharge ..... g.p.m. Date of test .....

12. **Tunnel:** Type of lining .....

Dimensions: .....
(Length, course, and cross sectional size)

Position of water bearing stratum with reference to portal of tunnel .....

Log of tunnel: (Preceding table for log of well may be used, if desired. Give footage from portal and character of materials, as pertinent.)

13. **Pumping Equipment:**

(a) Pump Deloo Model A8441 (Make, type and size) Capacity 35 g.p.m.

(b) Motor Deloo One H.P. 115/230 V. (Type and horsepower)

14. Location of area irrigated or to be irrigated, or place of use if for purposes other than irrigation.

Township North or South	Range E. or W. of Willamette Meridian	Section	Forty-acre Tract	Number Acres To Be Irrigated	Date of Reclamation
1 North	3 West	35	SW 1/4 of SE 1/4 of Sec 35 T in R 3 WWM	2½	1954

15. If the ground water supply is supplemental to an existing water supply, identification of any application for a permit, permit, certificate or adjudicated right to appropriate water made or held by the registrant.

.....

.....

GR-1938

Township 1 North Range 3 West, W.M.

North

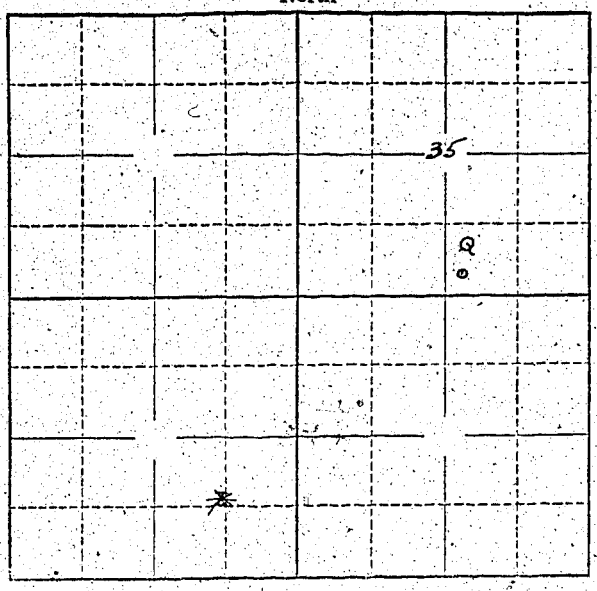

Locate well and acreage of irrigated land on plat.

Scale: 2" = 1 Mile

STATE OF OREGON
County of ..... } ss.

I, Carl Russell, being first duly sworn, do hereby certify that I have read the foregoing Registration Statement and that all of the items therein contained are true to the best of my knowledge and belief.

Carl Russell
Winona L. Russell
(Signature of Registrant)

Subscribed and sworn to before me this 7th day of July, 1958.

My commission expires MY COMMISSION EXPIRES MARCH 21, 1959
(Notary Public)

(SEAL)

CERTIFICATE OF REGISTRATION

STATE OF OREGON
County of Marion } ss.

This is to certify that the foregoing Registration Statement was received in the office of the State Engineer on the 10th day of July, 1958, at 8:00 o'clock A M. and has been duly recorded in said office in Book No. 9 of Registration Statements on page GR-1938

~~Construction shall be completed on or before ..... Application for extension of time must be made prior to expiration date.~~

Witness my hand this 9th day of February, 1959.

Lewis A. Stanley
(State Engineer)

$15.00

By .....
(Deputy)

GR-1938