

State Engineer
251 State Office Bldg
Salem, Oregon
SALEM, OREGON

Registration No. GR - 2011

Certificate No. GR - 1939

Registration Statement

OF CLAIMANT OF RIGHT TO APPROPRIATE GROUND WATER

TO THE STATE ENGINEER OF OREGON:

I, Walter J. Van Dyke

of 2040 N.W. Jackson School Rd County of Washington

State of Oregon do hereby make application for a certificate of registration as evidence of a right to appropriate ground water.

1. Source from which water is withdrawn is Pump
(Flowing well, pump well, infiltration trench, or tunnel)

2. Location is: 1/4 Mile North Hillsboro
(Approximate distance and direction from nearest city or town)

and is more particularly described as follows:

(a) Well 2070' W and 110' N from SE Corner Sec 30
(Give distance and bearing to corner of section or other legal subdivision)

being within SW 1/4 of SE 1/4 of Sec. 30 Twp. 1N Rge. 2W
(Smallest legal subdivision) (N. or S.) (E. or W.)

or (b) within limits of recorded platted property, town or city:

in Lot _____, Block _____ of _____
(Name of plat or addition)

County of Washington
(If within city or town, give name)

3. Construction Work was begun on Sept. 1947; was completed on Sept. 1947
(Date) (Date)

and the ground water claimed was first used for the purposes set out below on Sept. 1947
(Date)

since which time the water has been used Continuously
(Continuously or intermittently)

from 1947 to 1956
(Date) (Date)

4. Quantity of water claimed and used is 30 gallons per minute; 25 acre feet per year.

5. Purpose or Purposes for which water is used Irrigation

(Domestic, irrigation, municipal, manufacturing, industrial, etc.)

6. Description of Well: Depth 40 feet. Type Drilled
(Dug or drilled)

diameter 7 inches. Elevation of ground at well site 225 feet, mean sea level.
(As near as known)

Depth to water table 17 feet.

7. Capacity of Well: 30 g.p.m. with 22 feet drawdown.
_____ g.p.m. with _____ feet drawdown.


Date of test July 1956

If Flowing Well: Measured discharge _____ g.p.m. on _____
(Date)

Shut-in pressure at ground surface _____ lbs. per sq. in. on _____
(Date)

Water is controlled by _____
(Cap, valve, etc.)

Township 1N Range 2W W.M.
North

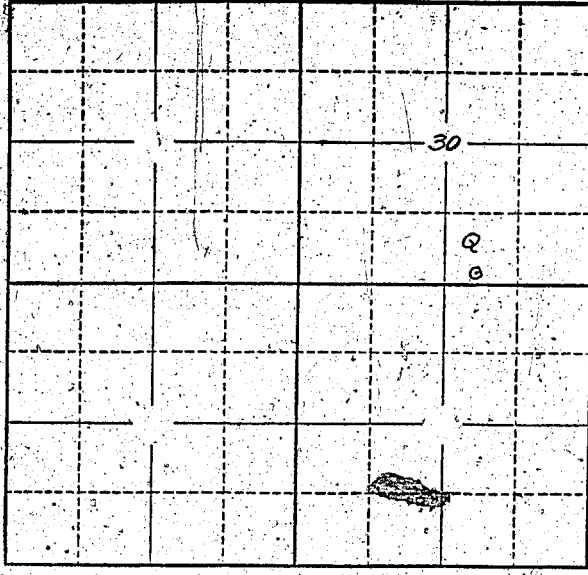

Locate well and acreage of irrigated land on plat.
Scale: 2" = 1 Mile

STATE OF OREGON

County of Marion } ss.

I, Mrs. Walter J. Van Dyke, being first duly sworn, do hereby certify that I have read the foregoing Registration Statement and that all of the items therein contained are true to the best of my knowledge and belief.

Mrs. Walter J. Van Dyke
(Signature of Registrant)

Subscribed and sworn to before me this 7th day of July 1958

My commission expires 12 June 1961

Wm. S. Bartholomew
(Notary Public)

(SEAL)

CERTIFICATE OF REGISTRATION

STATE OF OREGON

County of Marion } ss.

This is to certify that the foregoing Registration Statement was received in the office of the State Engineer on the 10th day of July 1958, at 2:00 o'clock P.M. and has been duly recorded in said office in Book No. 9 of Registration Statements on page GR-1939

Witness my hand this 9th day of February 1959

\$1500

Lewis A. Stanley
(State Engineer)

By _____
(Deputy)