

State Engineer
SALEM, OREGON
1955

Registration No. GR-2012
Certificate No. GR-1940

Registration Statement

OF CLAIMANT OF RIGHT TO APPROPRIATE GROUND WATER

TO THE STATE ENGINEER OF OREGON:

I, Rudolph E Zagelow
of Rt 4 Box 139 Hillsboro County of Washington
(Mailing address)

State of Oregon, do hereby make application for a certificate of registration as evidence of a right to appropriate ground water.

- Source from which water is withdrawn is pump well
(Flowing well, pump well, infiltration trench, or tunnel)
- Location is: 1 1/2 miles S.E. of Hillsboro on Munter Bridge Rd.
(Approximate distance and direction from nearest city or town)

and is more particularly described as follows:

(a) N 29° 0' E 2280 feet from SW corner Section 8
(Give distance and bearing to corner of section or other legal subdivision)
being within NW 1/4 of SW 1/4 of Sec. 8, Twp. 15, Rge. 20
(Smallest legal subdivision) (or sec. 8.) (or sec. 8.)

or (b) within limits of recorded platted property, town or city:

in Lot _____, Block _____ of _____
(Name of plat or addition)
County of _____
(If within city or town, give name)

3. Construction Work was begun on Aug. 1954; was completed on Sept. 1954
(Date) (Date)
and the ground water claimed was first used for the purposes set out below on Sept. 1954
(Date)

since which time the water has been used Continuously
(Continuously or intermittently)
from Sept. 1954 to 1958
(Date) (Date)

4. Quantity of water claimed and used is 63 gallons per minute; 25 acre feet per year.

5. Purpose or Purposes for which water is used Irrigation
(Domestic, irrigation, municipal, manufacturing, industrial, etc.)

6. Description of Well: Depth 60 feet. Type drilled
(Dug or drilled)
diameter 20 inches. Elevation of ground at well site 200 feet, mean sea level.
(As near as known)
Depth to water table 19 feet.

7. Capacity of Well: 100 g.p.m. with 3 feet drawdown.
_____ g.p.m. with _____ feet drawdown.


Date of test Sept. 1954

If Flowing Well: Measured discharge _____ g.p.m. on _____
(Date)

Shut-in pressure at ground surface _____ lbs. per sq. in. on _____
(Date)

Water is controlled by _____
(Cap, valve, etc.)

Township 1S Range 2W W.M.
North

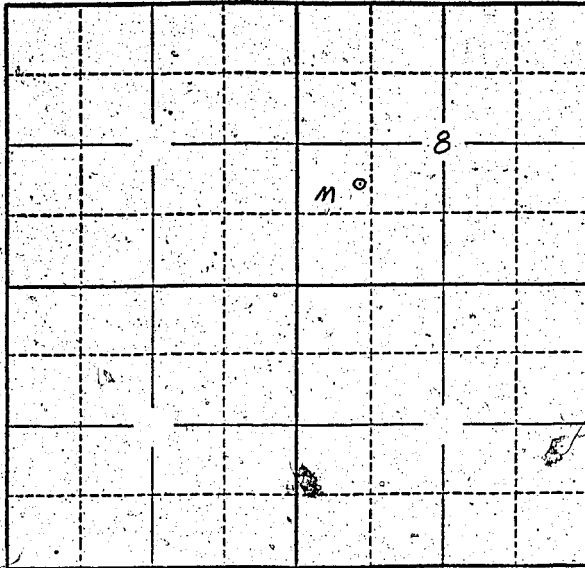

Locate well and acreage of irrigated land on plat.
Scale: 2" = 1 Mile

STATE OF OREGON

County of Marion } ss.

I, _____, being first duly sworn, do hereby certify that I have read the foregoing Registration Statement and that all of the items therein contained are true to the best of my knowledge and belief.

Rudolph E. Fogel
(Signature of Registrant)

Subscribed and sworn to before me this 7th day of July, 1958.

My commission expires 12th June 1961
Wm. J. Bartholomew
(Notary Public)

(SEAL)

CERTIFICATE OF REGISTRATION

STATE OF OREGON

County of Marion } ss.

This is to certify that the foregoing Registration Statement was received in the office of the State Engineer on the 10th day of July, 1958, at 8:00 o'clock A.M. and has been duly recorded in said office in Book No. 9 of Registration Statements on page GR-1940

Witness my hand this 9th day of February, 1959.

Lewis A. Stanley
(State Engineer)

By _____
(Deputy)

\$15.00