

STATE ENGINEER

Registration Statement

OF CLAIMANT OF RIGHT TO APPROPRIATE GROUND WATER

TO THE STATE ENGINEER OF OREGON:

I, Gordon Hallin

of 3560 E. Main - Hillsboro County of Wasco
(Mailing address)

State of Ore., do hereby make application for a certificate of registration as evidence of a right to appropriate ground water.

1. Source from which water is withdrawn is pump well
(Flowing well, pump well, infiltration trench, or tunnel)

2. Location is: 2 miles E of Hillsboro
(Appropriate distance and direction from nearest city or town)

and is more particularly described as follows:

(a) S 70° E 1090 feet from NW corner Section 4
(Give distance and bearing to corner of section or other legal subdivision)

being within Virginia Acres of Sec. 4, Twp. 1 S, Rge. 2 W
(Smallest legal subdivision) (N. or S.) (E. or W.)

or (b) within limits of recorded platted property, town or city: Hillsboro

in Lot 4, Block _____ of Virginia Acres
(Name of plat or addition)

Hillsboro County of Wasco
(If within city or town, give name)

3. Construction Work was begun on 1930; was completed on 1930
(Date) (Date)

and the ground water claimed was first used for the purposes set out below on 1930
(Date)

since which time the water has been used intermittently
(Continuously or intermittently)

from 1930 to 1958
(Date) (Date)

4. Quantity of water claimed and used is 50 gallons per minute; _____ acre feet per year.

5. Purpose or Purposes for which water is used garden and yard
(Domestic, irrigation, municipal, manufacturing, industrial, etc.)

6. Description of Well: Depth 37 feet. Type _____
(Dug or drilled)

diameter 4 inches. Elevation of ground at well site _____ feet mean sea level.
(As near as known)

Depth to water table 20 feet.

7. Capacity of Well: _____ g.p.m. with _____ feet drawdown.

_____ g.p.m. with _____ feet drawdown.


Date of test _____

If Flowing Well: Measured discharge _____ g.p.m. on _____
(Date)

Shut-in pressure at ground surface _____ lbs. per sq. in. on _____
(Date)

Water is controlled by cap valve
(Cap. valve, etc.)

Township 1 S Range 2 W, W.M.
North

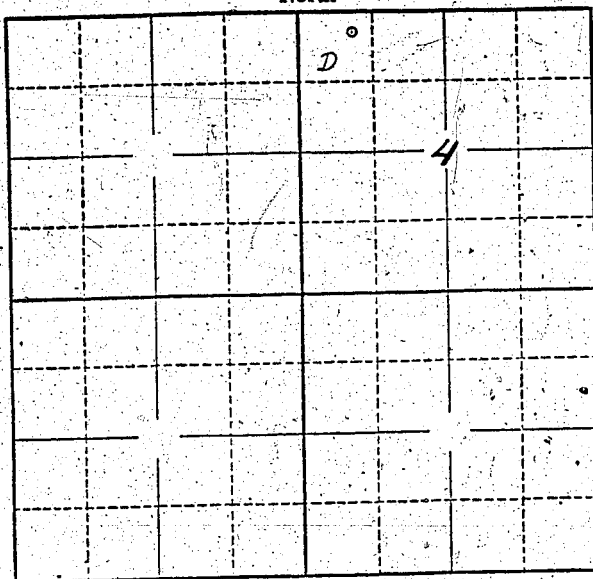

Locate well and acreage of irrigated land on plat.
Scale: 2" = 1 Mile

STATE OF OREGON }
County of Marion } ss.

I, Gordon R. Hallin, being first duly sworn, do hereby certify that I have read the foregoing Registration Statement and that all of the items therein contained are true to the best of my knowledge and belief.

Gordon R. Hallin
(Signature of Registrant)

Subscribed and sworn to before me this 7th day of July, 1958

My commission expires 12th June 1961 Wm. S. Bartholomew
(Notary Public)

(SEAL)

CERTIFICATE OF REGISTRATION

STATE OF OREGON }
County of Marion } ss.

This is to certify that the foregoing Registration Statement was received in the office of the State Engineer on the 10th day of July, 1958, at 8:00 o'clock A.M. and has been duly recorded in said office in Book No. 9 of Registration Statements on page GR-1911

Witness my hand this 9th day of February, 1959.
Laura A. Standley
(State Engineer)

\$15.00

By _____ (Deputy)

GR-1911