

RECEIVED  
JUL 17 1958  
STATE ENGINEER  
SALES DIVISION

Registration No. GR-2014

Certificate No. GR-1912

# Registration Statement

## OF CLAIMANT OF RIGHT TO APPROPRIATE GROUND WATER

TO THE STATE ENGINEER OF OREGON:

I, Dr. Hugh D. Stites

of 2517 26th Ave., Forest Grove County of Washington  
(Mailing address)

State of Oregon, do hereby make application for a certificate of registration as evidence of a right to appropriate ground water.

1. Source from which water is withdrawn is pumping well  
(Flowing well, pump well, infiltration trench, or tunnel)

2. Location is: 1/4 mile Northeast of Forest Grove, Ore.  
(Approximate distance and direction from nearest city or town)

and is more particularly described as follows:

(a) S 74° 36' E 1662.52 ft. from the Northwest corner of the Wm. Stokes  
D. L.C. No. 61 (Give distance and bearing to corner of section or other legal subdivision)

being within SW 1/4 of NE 1/4 of Sec. 31, Twp. 1N, Rge. 3W  
(Smallest legal subdivision) (N. or S.) (E. or W.)

and (b) within limits of recorded platted property, town or city:

in Lot 17/4/4, Block \_\_\_\_\_ of Curtis Subdivisions  
(Name of plat or addition)

County of Washington

(If within city or town, give name)

3. Construction Work was begun on May 1950; was completed on May 1950  
(Date) (Date)

and the ground water claimed was first used for the purposes set out below on 1951  
(Date)

since which time the water has been used intermittently  
(Continuously or intermittently)

from 1951 to present  
(Date) (Date)

4. Quantity of water claimed and used is 40 gallons per minute; \_\_\_\_\_ acre feet per year.

5. Purpose or Purposes for which water is used Irrigation for holly

and pasture  
(Domestic, irrigation, municipal, manufacturing, industrial, etc.)

6. Description of Well: Depth 120 feet. Type drilled

(Dug or drilled)

diameter 6 inches. Elevation of ground at well site 50 feet, mean sea level.  
(As near as known)

Depth to water table 80 feet.

7. Capacity of Well: 300 g.p.m. with \_\_\_\_\_ feet drawdown, unable to make this test without removing roof of pump house \_\_\_\_\_ g.p.m. with \_\_\_\_\_ feet drawdown.

Date of test \_\_\_\_\_

If Flowing Well: Measured discharge \_\_\_\_\_ g.p.m. on \_\_\_\_\_  
(Date)


Shut-in pressure at ground surface \_\_\_\_\_ lbs. per sq. in. on \_\_\_\_\_  
(Date)

Water is controlled by \_\_\_\_\_  
(Cap, valve, etc.)





Section 31  
 Township 1N ..... Range 3W ..... W.M.  
 North

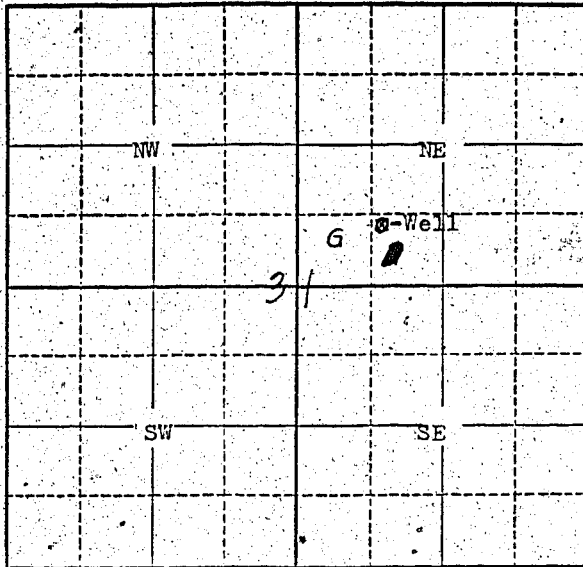

Locate well and acreage of irrigated land on plat.

Scale: 1" = 1 Mile

STATE OF OREGON

County of Washington } ss.


(Signature of Registrant)

Subscribed and sworn to before me this 9th day of July, 1958

My commission expires Jan 25, 1959 Marie Fleming  
 (Notary Public)

(SEAL)

**CERTIFICATE OF REGISTRATION**

STATE OF OREGON } ss.  
 County of Marion

This is to certify that the foregoing Registration Statement was received in the office of the State Engineer on the 10th day of July, 1958, at 8:00 o'clock A.M. and has been duly recorded in said office in Book No. 9 of Registration Statements on page GR-1912

Witness my hand this 9th day of February, 1959

Lewis A. Sturley  
 (State Engineer)

By \_\_\_\_\_ (Deputy)