

RECEIVED
STATE ENGINEER
SALEM, OREGON

Registration No. GR-2017

Certificate No. GR - 1944

Registration Statement

OF CLAIMANT OF RIGHT TO APPROPRIATE GROUND WATER

TO THE STATE ENGINEER OF OREGON:

I, Mountainside Cemetery Assoc.
of P.O. Box 95, Newberg, Ora. County of Washington
(Mailing address)

State of Oregon do hereby make application for a certificate of registration as evidence of a right to appropriate ground water.

1. Source from which water is withdrawn is Pump Well
(Flowing well, pump well, infiltration trench, or tunnel)

2. Location is: Nine miles N. of Newberg, Ora.
(Approximate distance and direction from nearest city or town)

and is more particularly described as follows:

Be SW. ^{sec 16.} 1125' N. and 800' E. from SW corner Section 16
(Give distance and bearing to corner of section or other legal subdivision)
being within NE^{1/4} SW^{1/4} SW^{1/4} of Sec. 16, Twp. 2 S., Rge. 2 W.W.M.
(Smallest legal subdivision)

or (b) within limits of recorded platted property, town or city:

in Lot _____, Block _____ of _____
(Name of plat or addition)

County of _____
(If within city or town, give name)

3. Construction Work was begun on 1953
(Date); was completed on June 9, 1953
(Date)

and the ground water claimed was first used for the purposes set out below on Sept. 15, 1953
(Date)

since which time the water has been used intermittently
(Continuously or intermittently)

from April 15 to Oct 1
(Date) (Date)

4. Quantity of water claimed and used is 36 gallons per minute; acre
feet per year.

5. Purpose or Purposes for which water is used Irrigation of Cemetery
1/2 Acre

(Domestic, irrigation, municipal, manufacturing, industrial, etc.)

6. Description of Well: Depth 251 feet. Type dry/dad
(Dug or drilled)
diameter 6" to 112" inches. Elevation of ground at well site 200 feet, mean sea level.
(As near as known)

Depth to water table 87 feet.

7. Capacity of Well: 39 g.p.m. with 155 feet drawdown.

..... g.p.m. with feet drawdown.

Date of test June 9, 1953

If Flowing Well: Measured discharge g.p.m. on
(Date)

Shut-in pressure at ground surface lbs. per sq. in. on
(Date)

Water is controlled by
(Cap. valve, etc.)

8. Casing: (Give diameter, commercial specifications and depth below ground surface of each casing size.)

4" inch diameter " from 112' to 172' feet
 6" inch diameter steel casing from 0 to 53' feet
 inch diameter from to feet
 inch diameter from to feet

Describe and show depth of shoe, plug, adapter, liner or other details:

9. Perforated Casings or Screens:

None - open end (Number per foot and size of perforations, or describe screen) from to
from to
from to
from to
from to

10. Log of Well: (Describe each stratum or formation clearly, indicate if water bearing, and give thickness and depth as indicated.)

If log of well is not available, give name and address of driller.

A. T. Gault, 3250 S.W. 185th, Aloha, Oregon

11. Infiltration Trench: Covered or open

Dimensions: Length _____ ft. Minimum depth _____ ft. Maximum depth _____ ft.

Bottom width _____ ft. **Discharge** _____ g.p.m. **Date of test** _____

12. Tunnel: Type of lining _____


Position of water bearing stratum with reference to portal of tunnel

Log of tunnel: (Preceding table for log of well may be used, if desired. Give footage from portal and character of materials, as pertinent.)

13. Pumping Equipment:

(a) Pump Pacific, submersible, 14 stages Capacity 36 g.p.m.


(b) Motor 3 phase 5 H.P.
(Type and horsepower)

14. Location of area irrigated or to be irrigated, or place of use if for purposes other than irrigation.

15. If the ground water supply is supplemental to an existing water supply, identification of any application for a permit, permit, certificate or adjudicated right to appropriate water made or held by the registrant.

Township 2S Range 2W, W.M.

North

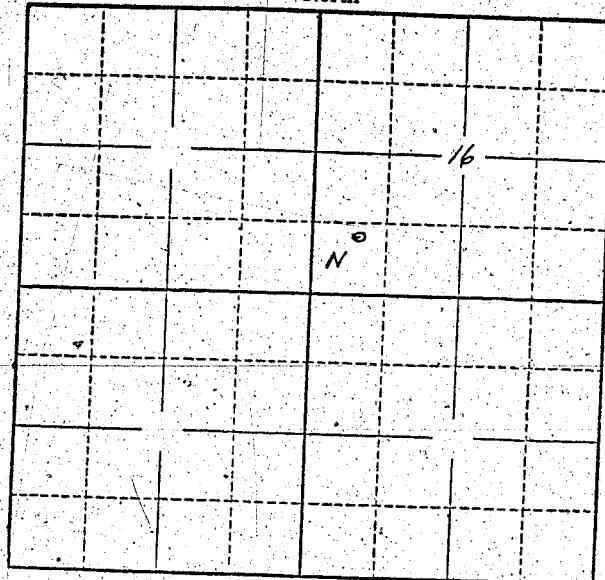

Locate well and acreage of irrigated land on plat.

Scale: 2" - 1 Mile

STATE OF OREGON

County of _____

{ss.

I, George Sandland, being first duly sworn, do hereby certify that I have read the foregoing Registration Statement and that all of the items therein contained are true to the best of my knowledge and belief.

George Sandland Sec. Taxas
(Signature of Registrant)

Subscribed and sworn to before me this 7th day of July, 19⁵⁸.

My commission expires 12th June 1961

Wm. S. Bartholomew
(Notary Public)

(SEAL)

CERTIFICATE OF REGISTRATION

STATE OF OREGON

County of Marion

{ss.

This is to certify that the foregoing Registration Statement was received in the office of the State Engineer on the 10th day of July, 19⁵⁸, at 2:00 o'clock P.M. and has been duly recorded in said office in Book No. 9 of Registration Statements on page GR-1944.

Witness my hand this 9th day of February

19⁵⁹

Levitt A. Stanley
(State Engineer)

By

(Deputy)

\$15.00

GR - 1944