

RECEIVED
JUN 24 1955
STATE ENGINEER

Registration No. GR - 203

Certificate No. GR - 3810

Registration Statement

OF CLAIMANT OF RIGHT TO APPROPRIATE GROUND WATER

TO THE STATE ENGINEER OF OREGON:

I, Wm. D. Heatherington
of R 4 B 352-A Corvallis County of Linn
(Mailing address)
State of Oregon, do hereby make application for a certificate of registration as evidence
of a right to appropriate ground water.

1. Source from which water is withdrawn is pump well
(Flowing well, pump well, infiltration trench, or tunnel)

2. Location is: 3.2 miles S.E. of Corvallis
(Approximate distance and direction from nearest city or town)

and is more particularly described as follows:

(a) About 1720 feet east and 200 feet from W 1/4 corner Section 8,
(Give distance and bearing to corner of section or other legal subdivision)
being within SE 1/4 of SW 1/4 of Sec. 8 Twp. 12 S. Rge. 4 W.
(Smallest legal subdivision) (N. or S.) (E. or W.)

or (b) within limits of recorded platted property, town or city:

in Lot _____, Block _____ of _____
(Name of plat or addition)
County of Linn
(If within city or town, give name)

3. Construction Work was begun on Approx Sep 1950; was completed on Approx Sep 1950
(Date) (Date)

and the ground water claimed was first used for the purposes set out below on Sep 1950
(Date)

since which time the water has been used intermittently
(Continuously or intermittently)

from that time to present time
(Date) (Date)

4. Quantity of water claimed and used is 34 gallons per minute; _____ acre
feet per year.

5. Purpose or Purposes for which water is used irrigation

(Domestic, irrigation, municipal, manufacturing, industrial, etc.)

6. Description of Well: Depth 50 feet. Type drilled
(Dug or drilled)

diameter 10 inches. Elevation of ground at well site _____ feet, mean sea level.
(As near as known)

Depth to water table _____ feet.

7. Capacity of Well: 50 g.p.m. with _____ feet drawdown.

60 g.p.m. with _____ feet drawdown.

Date of test June 13, 1955

If Flowing Well: Measured discharge _____ g.p.m. on _____
(Date)

Shut-in pressure at ground surface _____ lbs. per sq. in. on _____
(Date)

Water is controlled by _____
(Cap, valve, etc.)

This information is not available

Describe and show depth of shoe, plug, adapter, liner or other details: _____

This information is not available

10. **Log of Well:** (Describe each stratum or formation clearly, indicate if water bearing, and give thickness and depth as indicated.)

GR 3910

If log of well is not available, give name and address of driller. Stapleton Bros.,

Salem, Oregon

11. Infiltration Trench: Covered or open: _____

Dimensions: Length _____ ft. Minimum depth _____ ft. Maximum depth _____ ft.

Bottom width ft. Discharge g.p.m. Date of test

12. Tunnel: Type of lining _____

Dimensions: _____
(Length, course, and cross sectional size)

Position of water bearing stratum with reference to portal of tunnel

Log of tunnel: (Preceding table for log of well may be used, if desired. Give footage from portal and character of materials, as pertinent.)

13. Pumping Equipment:

(a) Pump Fairbanks-Morse-8 inch centrifugal Capacity 60 g.p.m.
(Make, type and size)


(b) Motor 3 HP Fairbanks-Morse
(Type and horsepower)

14. Location of area irrigated or to be irrigated, or place of use if for purposes other than irrigation.

[illegible]

15. If the ground water supply is supplemental to an existing water supply, identification of any application for a permit, permit, certificate or adjudicated right to appropriate water made or held by the registrant.

Township 12-S Range 4-W W.M.
North

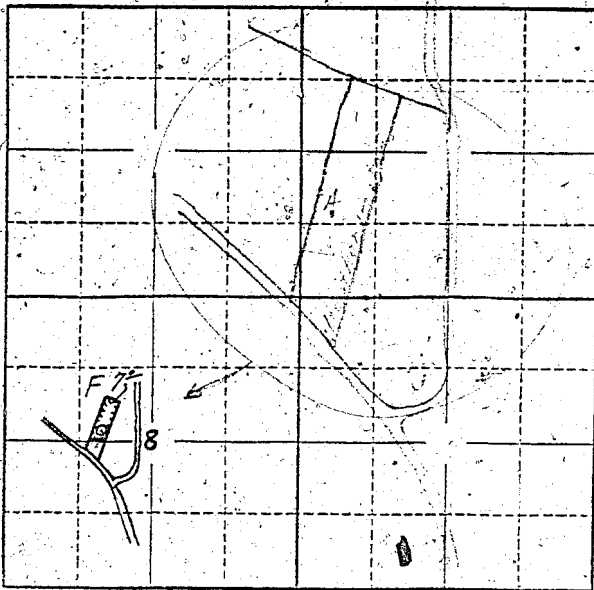

Locate well and acreage of irrigated land on plat.

Scale: 2" = 1 Mile

STATE OF OREGON

County of Benton

ss.

I, Wm D Heatherington, being first duly sworn, do hereby certify that I have read the foregoing Registration Statement and that all of the items therein contained are true to the best of my knowledge and belief.

(Signature of Registrant)

Subscribed and sworn to before me this 19 day of November, 1959

NOTARY PUBLIC FOR OREGON

My commission expires March 29, 1960

(Notary Public)

(SEAL)

This statement is being filed in lieu of the original statement which was filed in this office on July 9, 1958, and was subsequently lost after its return to the owner for completion.

CERTIFICATE OF REGISTRATION

STATE OF OREGON

County of Marion

ss.

This is to certify that the foregoing Registration Statement was received in the office of the State Engineer on the 9th day of July, 1959, at 8:00 o'clock A.M. and has been duly recorded in said office in Book No. 16 of Registration Statements on page GR-3810

Witness my hand this 4th day of December, 1959

(State Engineer)

By

(Deputy)

GR