

Registration Statement

Reg. no. GR-2047
REGISTRATION NO. _____
CERTIFICATE NO. GR-1973

OF CLAIMANT OF RIGHT TO APPROPRIATE GROUND WATER

(Under Chapter 708, Oregon Laws 1955.)

TO THE STATE ENGINEER OF OREGON:

I, RAYMOND KILLIN
of IRL AUMSVILLE County of MARION
State of OREGON, do hereby make application for a certificate of registration as evidence
of a right to appropriate ground water.

- 1. Source from which water is withdrawn is pump well
(Flowing well, pump well, infiltration trench, or tunnel)
- 2. Location is: 5 miles SW from Stayton, Oregon
(Approximate distance and direction from nearest city or town)

and is more particularly described as follows:

(a) S18°15'E, 1885' from NW cor. sec. 30 TOS. R1W
(Give distance and bearing to corner of section or other legal subdivision)
being within SW $\frac{1}{4}$ of the NW $\frac{1}{4}$ of Sec. 30, Twp. 9 S., Rge. 1 W.
(Smallest legal subdivision) (N. or S.) (E. or W.)

or (b) within limits of recorded platted property, town or city:
in Lot _____, Block _____ of _____
(Name of plat or addition)
County of _____
(If within city or town, give name)

3. Construction Work was begun on 1953; was completed on Aug 8, 1953
(Date) (Date)
and the ground water claimed was first used for the purposes set out below on June 15, 1947 (See X)
(Date)
since which time the water has been used Continuously
(Continuously or Intermittently)

from June 15, 1947 to July 5, 1953
(Date) (Date)

4. Quantity of water claimed and used is 350 gallons per minute; _____ acre
feet per year.

5. Purpose or Purposes for which water is used Irrigation of crops

(Domestic, irrigation, municipal, manufacturing, industrial, etc.)
6. Description of Well: Depth 19 feet. Type drilled
(Dug or drilled)
diameter 8 inches. Elevation of ground at well site 275 feet, mean sea level.
(As near as known)
Depth to water table 6 feet.

7. Capacity of Well: 350 g.p.m. with 5 feet drawdown.
_____ g.p.m. with _____ feet drawdown.

Date of test Aug 1953

If Flowing Well: Measured discharge _____ g.p.m. on _____
(Date)

Shut-in pressure at ground surface _____ lbs. per sq. in. on _____
(Date)

Water is controlled by _____
(Cap, valve, etc.)

(* - Water pumped from nearby creek 100 ft from well-site beginning June 15, 1947. Creek bulldozed in and covered. well drilled immediately in general vicinity)

8. Casing: (Give diameter, commercial specifications and depth below ground surface of each casing size.)

8 inch diameter steel casing from 0 to 20 feet
 inch diameter from to feet
 inch diameter from to feet
 inch diameter from to feet

Describe and show depth of shoe, plug, adapter, liner or other details:

9. Perforated Casings or Screens:

12/A 3/4 X 2 from 12 to 20 ft.
(Number per foot and size of perforations, or describe screen)
 from to
 from to
 from to

10. Log of Well: (Describe each stratum or formation clearly, indicate if water bearing, and give thickness and depth as indicated.)

MATERIAL	Thickness (Feet)	Depth to Bottom (Feet)
Sandy alluvial topsoil	8	15
RIVER gravel uncemented	15	—

If log of well is not available, give name and address of driller. Marion West

11. Infiltration Trench: Covered or open

Dimensions: Length ft. Minimum depth ft. Maximum depth ft.
 Bottom width ft. Discharge g.p.m. Date of test

12. Tunnel: Type of lining

Dimensions:
(Length, course, and cross sectional size)
 Position of water bearing stratum with reference to portal of tunnel

Log of tunnel: (Preceding table for log of well may be used, if desired. Give footage from portal and character of materials, as pertinent.)

13. Pumping Equipment:


(a) Pump 3" X 4" centrifugal Capacity 350 g.p.m.
(Make, type and size)
 (b) Motor 15 hp electric
(Type and horsepower)

14. Location of area irrigated or to be irrigated, or place of use if for purposes other than irrigation.

Township North or South	Range E. or W. of Willamette Meridian	Section	Forty-acre Tract	Number Acres To Be Irrigated	Date of Reclamation
T9S	R1W	Sec 30	SW 1/4 of the NW 1/4	22.30 Acs	June 15, 1947
"	"	"	NW 1/4 of the SW 1/4	1.0	" "
				<u>23.3</u> Ac	

15. If the ground water supply is supplemental to an existing water supply, identification of any application for a permit, permit, certificate or adjudicated right to appropriate water made or held by the registrant.

Township T9S Range R1W W.M.
North

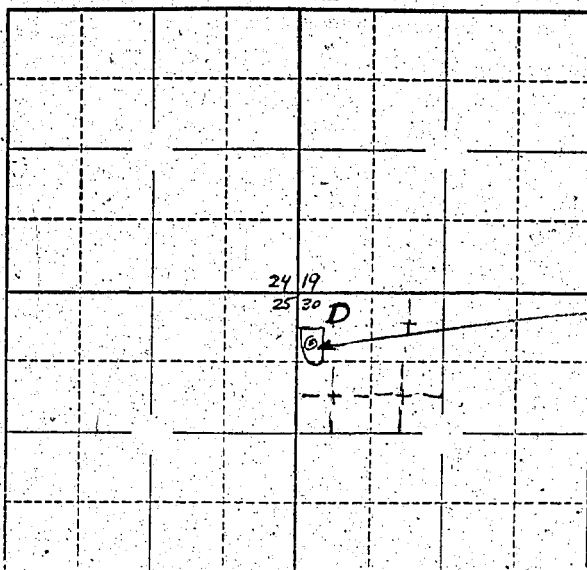

Locate well and acreage of irrigated land on plat:
Scale: 2" = 1 Mile

STATE OF OREGON

County of Marion } ss.

I, Raymond Killen, being first duly sworn, do hereby certify that I have read the foregoing Registration Statement and that all of the items therein contained are true to the best of my knowledge and belief.

Raymond Killen
(Signature of Registrant)

Subscribed and sworn to before me this 9 day of July, 1958

My commission expires Jan 21-1959

Lucian B. [unclear]
(Notary Public)

(SEAL)

CERTIFICATE OF REGISTRATION

STATE OF OREGON

County of Marion } ss.

This is to certify that the foregoing Registration Statement was received in the office of the State Engineer on the 10th day of July, 1958, at 3:30 o'clock P.M. and has been duly recorded in said office in Book No. 9 of Registration Statements on page GR-1973

~~Construction shall be completed by _____ and the water consensately applied to beneficial use by _____~~

Witness my hand this 9th day of February, 1959

Elmer A. [unclear]
(State Engineer)

By _____
(Deputy)

GR-1973

\$1500