

Clark place

Registration No. GR -2048
Certificate No. GR -1974

Registration Statement

OF CLAIMANT OF RIGHT TO APPROPRIATE GROUND WATER

TO THE STATE ENGINEER OF OREGON:

I, Ed. Glidewell - Lee D. Glidewell - Ralph E. Glidewell

of Rt. Lunsville County of Marion

State of Oregon do hereby make application for a certificate of registration as evidence of a right to appropriate ground water.

1. Source from which water is withdrawn is pump well
(Flowing well, pump well, infiltration trench, or tunnel)

2. Location is: 5 miles SW. Stayton, Oregon
(Approximate distance and direction from nearest city or town)

and is more particularly described as follows:

(a) S 7° 30' W 2185' from NE Cor. Sec 25 T9S R2W
(Give distance and bearing to corner of section or other legal subdivision)

being within SE 1/4 of the NE 1/4 of Sec. 25, Twp. 9S, Rge. 2W
(Smallest legal subdivision) (N. or S.) (E. or W.)

or (b) within limits of recorded platted property, town or city:

in Lot _____, Block _____ of _____
(Name of plat or addition)

County of _____
(If within city or town, give name)

3. Construction Work was begun on March 1940; was completed on March 1940
(Date) (Date)

and the ground water claimed was first used for the purposes set out below on Same
(Date)

since which time the water has been used Continuously
(Continuously or intermittently)

from May 1940 to Present
(Date) (Date)

4. Quantity of water claimed and used is 350 gallons per minute; _____ acre feet per year.

5. Purpose or Purposes for which water is used irrigation

(Domestic, irrigation, municipal, manufacturing, industrial, etc.)

6. Description of Well: Depth 29 feet. Type drilled
(Dug or drilled)

diameter 8 inches. Elevation of ground at well site 275 feet, mean sea level.
(As near as known)

Depth to water table 6 feet.

7. Capacity of Well: 350 g.p.m. with 3 feet drawdown.

_____ g.p.m. with _____ feet drawdown.


Date of test March 1940

If Flowing Well: Measured discharge _____ g.p.m. on _____
(Date)

Shut-in pressure at ground surface _____ lbs. per sq. in. on _____
(Date)

Water is controlled by _____
(Cap. valve, etc.)

Township 95 Range 2W W.M.
North

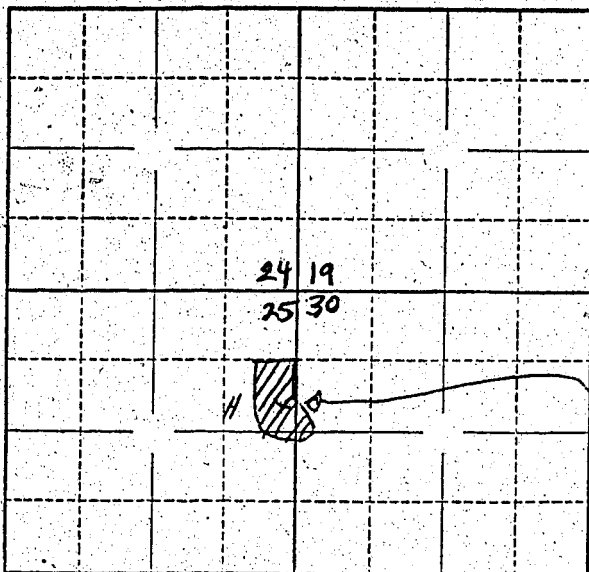

Locate well and acreage of irrigated land on plat.
Scale: 2" = 1 Mile

STATE OF OREGON

County of Marion

ss.

I, E.D. Slidewell, being first duly sworn, do hereby certify that I have read the foregoing Registration Statement and that all of the items therein contained are true to the best of my knowledge and belief.

E.D. Slidewell
(Signature of Registrant)

Subscribed and sworn to before me this 10th day of July, 1958

My commission expires 12th June 1961

Wm. S. Bartholomew
(Notary Public)

(SEAL)

CERTIFICATE OF REGISTRATION

STATE OF OREGON

County of Marion

ss.

This is to certify that the foregoing Registration Statement was received in the office of the State Engineer on the 10th day of July, 1958, at 8:00 o'clock A.M. and has been duly recorded in said office in Book No. 9 of Registration Statements on page GR-1974

Witness my hand this 9th day of February, 1959

Lewis A. Atkinson
(State Engineer)

By _____

(Deputy)

GR - 1974

\$15.00