

Registration Statement

OF CLAIMANT OF RIGHT TO APPROPRIATE GROUND WATER

TO THE STATE ENGINEER OF OREGON:

I, E.D. Glidewell - South well site
 of RT 1, Humsville County of Marion
(Mailing address)
 State of Oregon, do hereby make application for a certificate of registration as evidence
 of a right to appropriate ground water.

- Source from which water is withdrawn is pump well #1
(Flowing well, pump well, infiltration trench, or tunnel)
- Location is: 5 miles SW Stayton, Oregon
(Approximate distance and direction from nearest city or town)

and is more particularly described as follows:

(a) S 54° 00' E 1035' from NW Cor Sec 30 T9S R1W
(Give distance and bearing to corner of section or other legal subdivision)
 being within NW 1/4 of the NW 1/4 of Sec. 30, Twp. T9S, Rge. R1W
(Smallest legal subdivision) (N. or S.) (E. or W.)
 or (b) within limits of recorded platted property, town or city:
 in Lot _____, Block _____ of _____
(Name of plat or addition)

County of _____
(If within city or town, give name)

3. Construction Work was begun on March 1940; was completed on March 1940
(Date) (Date)
 and the ground water claimed was first used for the purposes set out below on Same
(Date)
 since which time the water has been used Continuously
(Continuously or intermittently)
 from March 1940 to present
(Date) (Date)

4. Quantity of water claimed and used is 350 gallons per minute; _____ acre
 feet per year.

5. Purpose or Purposes for which water is used irrigation

6. Description of Well: Depth 25 feet. Type drilled
(Domestic, irrigation, municipal, manufacturing, industrial, etc.) (Dug or drilled)
 diameter 8 inches. Elevation of ground at well site 275 feet, mean sea level.
(As near as known)
 Depth to water table 10 feet.

7. Capacity of Well: 350 g.p.m. with 5 feet drawdown.
 _____ g.p.m. with _____ feet drawdown.

Date of test March 1940

If Flowing Well: Measured discharge _____ g.p.m. on _____
(Date)

Shut-in pressure at ground surface _____ lbs. per sq. in. on _____
(Date)

Water is controlled by _____
(Cap, valve, etc.)

8. Casing: (Give diameter, commercial specifications and depth below ground surface of each casing size.)

8 inch diameter steel casing from 0 to 25 feet
 inch diameter _____ from _____ to _____ feet
 inch diameter _____ from _____ to _____ feet
 inch diameter _____ from _____ to _____ feet

Describe and show depth of shoe, plug, adapter, liner or other details: _____

9. Perforated Casings or Screens:

10/ft 3/4" x 2" from 12 to 25
(Number per foot and size of perforations, or describe screen)

from _____ to _____
 from _____ to _____
 from _____ to _____

10. Log of Well: (Describe each stratum or formation clearly, indicate if water bearing, and give thickness and depth as indicated.)

MATERIAL	Thickness (Feet)	Depth to Bottom (Feet)
Sandy alluvial - Top soil	8	17
River gravel - (uncemented)	17	—

If log of well is not available, give name and address of driller. Main West

11. Infiltration Trench: Covered or open

Dimensions: Length ft. Minimum depth ft. Maximum depth ft.

Bottom width ft. Discharge g.p.m. Date of test

12. Tunnel: Type of lining

Dimensions: (Length, course, and cross sectional size)

Position of water bearing stratum with reference to portal of tunnel

Log of tunnel: (Preceding table for log of well may be used, if desired. Give footage from portal and character of materials, as pertinent.)

13. Pumping Equipment:

(a) Pump 3" pump - centrifugal Capacity 350 g.p.m. (Make, type and size)


(b) Motor 15 hp - electric (Type and horsepower)

14. Location of area irrigated or to be irrigated, or place of use if for purposes other than irrigation.

Township North or South	Range E. or W. of Williamsite Meridian	Section	Forty-acre Tract	Number Acres To Be Irrigated	Date of Reclamation
T9S	R1W	30	NW 1/4 of T1N & NW 1/4	23.8	March 1940
T9S	R1W	30	NE 1/4 of the NW 1/4	4.3	" "
				<u>28.1</u>	
T9S	R1W	19	SW 1/4 of SW 1/4	17.3	" "
"	"	"	SE 1/4 of SW 1/4	3.4	" "
				<u>48.5 Total</u>	

15. If the ground water supply is supplemental to an existing water supply, identification of any application for a permit, permit, certificate or adjudicated right to appropriate water made or held by the registrant.

Township 9S Range 1W W.M.
North

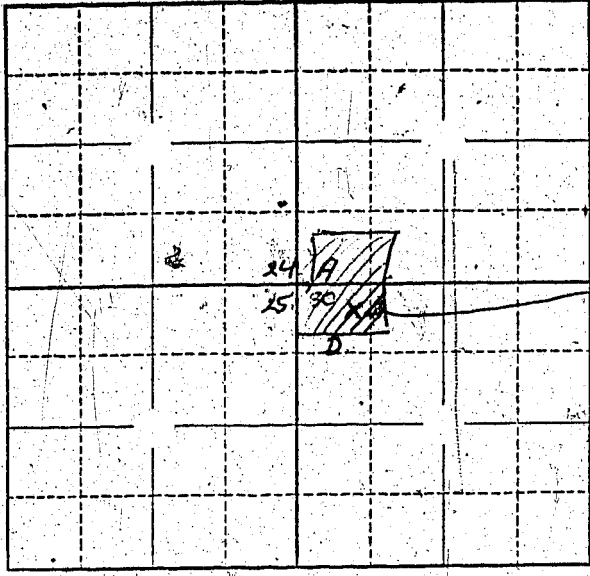

NPII
site

Locate well and acreage of irrigated land on plat.
Scale: 2" = 1 Mile

STATE OF OREGON }
County of Marion } ss.

I, E.D. Edsall being first duly sworn, do hereby certify that I have read the foregoing Registration Statement and that all of the items therein contained are true to the best of my knowledge and belief.

E.D. Edsall
(Signature of Registrant)

Subscribed and sworn to before me this 10th day of July, 1958

My commission expires 12th June 1961 Wm. S. Bartholomew
(Notary Public)

(SEAL)

CERTIFICATE OF REGISTRATION

STATE OF OREGON }
County of Marion } ss.

This is to certify that the foregoing Registration Statement was received in the office of the State Engineer on the 10th day of July, 1958, at 10:00 o'clock A. M. and has been duly recorded in said office in Book No. 9 of Registration Statements on page GR-1975

Witness my hand this 9th day of February, 1959

Lawrence A. Cottanley
(State Engineer)

By _____ (Deputy)

\$17.85