

RECEIVED
JUL 17 1958
STATE ENGINEER
SALEM, OREGON

Registration No. GR - 2051
Certificate No. GR - 1977

Registration Statement

OF CLAIMANT OF RIGHT TO APPROPRIATE GROUND WATER

TO THE STATE ENGINEER OF OREGON:

I, Ralph E. Glidenell
of Pt. Aunsville County of Marion
State of Oregon, do hereby make application for a certificate of registration as evidence
of a right to appropriate ground water.

1. Source from which water is withdrawn is pump well
(Flowing well, pump well, infiltration trench, or tunnel)
2. Location is: N 30° 30' W 1815' from SE Cor. Sec 24 T9S R2W
(Approximate distance and direction from nearest city or town)

and is more particularly described as follows:

(a) 5 miles SW Stanton, Oregon
(Give distance and bearing to corner of section or other legal subdivision)
being within NE 1/4 of the SE 1/4 of Sec. 24, Twp. 9S, Rge. 2W
(Smallest legal subdivision) (N. or S.) (E. or W.)
or (b) within limits of recorded platted property, town or city:
in Lot _____, Block _____ of _____
(Name of plat or addition)

County of _____
(If within city or town, give name)

3. Construction Work was begun on April 1945; was completed on April 10, 1945
(Date) (Date)
and the ground water claimed was first used for the purposes set out below on Same
(Date)
since which time the water has been used Continuously
(Continuously or intermittently)
from May 1945 to present
(Date) (Date)

4. Quantity of water claimed and used is 350 gallons per minute; _____ acre
feet per year.


5. Purpose or Purposes for which water is used Irrigation of crops
(Domestic, irrigation, municipal, manufacturing, industrial, etc.)

6. Description of Well: Depth 21 feet. Type Drilled
(Dug or drilled)
diameter 8 inches. Elevation of ground at well site 275 feet, mean sea level.
(As near as known)
Depth to water table 8 feet.

7. Capacity of Well: 350 g.p.m. with 6 feet drawdown.
_____ g.p.m. with _____ feet drawdown.

Date of test April 1945
If Flowing Well: Measured discharge _____ g.p.m. on _____ (Date)
Shut-in pressure at ground surface _____ lbs. per sq. in. on _____ (Date)
Water is controlled by _____
(Cap, valve, etc.)

Township 9S Range 2W, W.M.
North

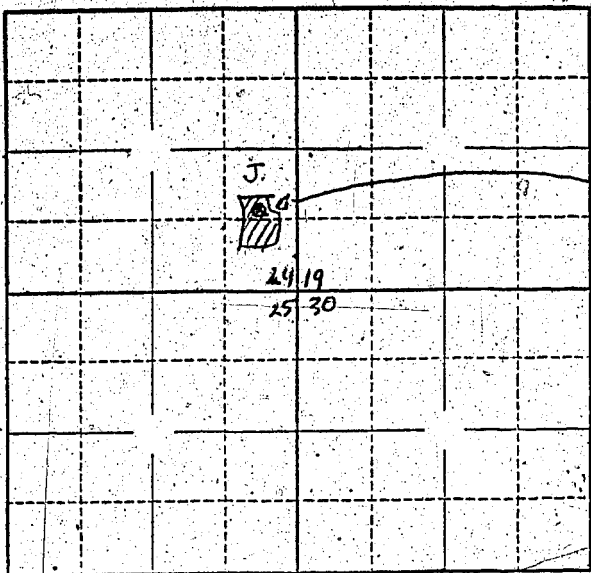

well site

Locate well and acreage of irrigated land on plat.
Scale: 2" - 1 Mile

STATE OF OREGON

County of: _____ } ss.

I, Ralph E. Johnson, being first duly sworn, do hereby certify that I have read the foregoing Registration Statement and that all of the items therein contained are true to the best of my knowledge and belief.

Ralph E. Johnson
(Signature of Registrant)

Subscribed and sworn to before me this 11 day of July, 1958

My commission expires G. W. SCHACHTSICK
My Commission Expires Aug. 28, 1961

G. W. Schachtsick
(Notary Public)

(SEAL)

CERTIFICATE OF REGISTRATION

STATE OF OREGON

County of Marion } ss.

This is to certify that the foregoing Registration Statement was received in the office of the State Engineer on the 10th day of July, 1958, at 3:30 o'clock P. M. and has been duly recorded in said office in Book No. 9 of Registration Statements on page GR-1977

Witness my hand this 9th day of February, 1959

Lewis A. Stanley
(State Engineer)

By _____
(Deputy)

\$1520

GR -1977