

Registration Statement

OF CLAIMANT OF RIGHT TO APPROPRIATE GROUND WATER

TO THE STATE ENGINEER OF OREGON:

I, Grant L. Kightlinger
 of 1187 So. Cassin, Salem, County of M.A. Wheeler
(Mailing address)
 State of Oregon, do hereby make application for a certificate of registration as evidence
 of a right to appropriate ground water.

1. Source from which water is withdrawn, is Pump well
(Flowing well, pump well, infiltration trench, or tunnel)

2. Location is: _____
(Approximate distance and direction from nearest city or town)

and is more particularly described as follows: 1580 feet west & 900 feet south from NE corner Sec. 21,

(a) One and one-half miles east of Beasleys, OR
(Give distance and bearing to corner of section or other legal subdivision)
 being within NW 1/4 + NE 1/4 of Sec. 21, Twp. 6 S, Rge. 2 W
(Smallest legal subdivision) (or S.) (or W.)

or (b) within limits of recorded platted property, town or city: _____

in Lot _____, Block _____ of _____
(Name of plat or addition)
 _____ County of _____
(If within city or town, give name)

3. Construction Work was begun on 1943; was completed on 1943
(Date) (Date)

and the ground water claimed was first used for the purposes set out below on 1943
(Date)

since which time the water has been used house and irrigation
(Continuously or intermittently)
 from 1943 to 1958
(Date) (Date)

4. Quantity of water claimed and used is 140 gallons per minute; _____ acre
 feet per year.

5. Purpose or Purposes for which water is used Domestic and irrigation
(Domestic, irrigation, municipal, manufacturing, industrial, etc.)

6. Description of Well: Depth 90 feet. Type drilled
(Dug or drilled)
 diameter 10 inches. Elevation of ground at well site _____ feet, mean sea level.
(As near as known)
 Depth to water table 17 feet.

7. Capacity of Well: 500 g.p.m. with 14 inches feet drawdown.
 _____ g.p.m. with _____ feet drawdown.

Date of test _____

If Flowing Well: Measured discharge _____ g.p.m. on _____
(Date)

Shut-in pressure at ground surface _____ lbs. per sq. in. on _____
(Date)

Water is controlled by _____
(Cap, valve, etc.)

8. Casing: (Give diameter, commercial specifications and depth below ground surface of each casing size.)

10 inch diameter steel casing from 0 to 90 feet
inch diameter from to feet
inch diameter from to feet
inch diameter from to feet

Describe and show depth of shoe, plug, adapter, liner or other details:

9. Perforated Casings or Screens:

yes unknown from 75 to 95
(Number per foot and size of perforations, or describe screen)
from to
from to
from to

10. Log of Well: (Describe each stratum or formation clearly, indicate if water bearing, and give thickness and depth as indicated.)

MATERIAL	Thickness (Feet)	Depth to Bottom (Feet)
unknown		

If log of well is not available, give name and address of driller. Small Bros.

11. Infiltration Trench: Covered or open

Dimensions: Length Minimum depth ft. Maximum depth ft.
Bottom width ft. Discharge g.p.m. Date of test

12. Tunnel: Type of lining

Dimensions: (Length, course, and cross sectional size)
Position of water bearing stratum with reference to portal of tunnel

Log of tunnel: (Preceding table for log of well may be used, if desired. Give footage from portal and character of materials, as pertinent.)

13. Pumping Equipment:

(a) Pump Centrifugal Capacity 150 g.p.m.
(Make, type and size)


(b) Motor 5 HP Electric
(Type and horsepower)

14. Location of area irrigated or to be irrigated, or place of use if for purposes other than irrigation.

Township North or South	Range E. or W. of Willamette Meridian	Section	Forty-acre Tract	Number Acres To Be Irrigated	Date of Reclamation
T68	R2W	21	NW ¹ / ₄ of NE ¹ / ₄	14 ⁰	1953
"	"	"	NE ¹ / ₄ of NW ¹ / ₄	4 ⁰	"
"	"	"	SW ¹ / ₄ of NW ¹ / ₄	2 ⁰	"
				20 ⁰	

15. If the ground water supply is supplemental to an existing water supply, identification of any application for a permit, permit, certificate or adjudicated right to appropriate water made or held by the registrant.

Township 65 Range 2W W.M.
North

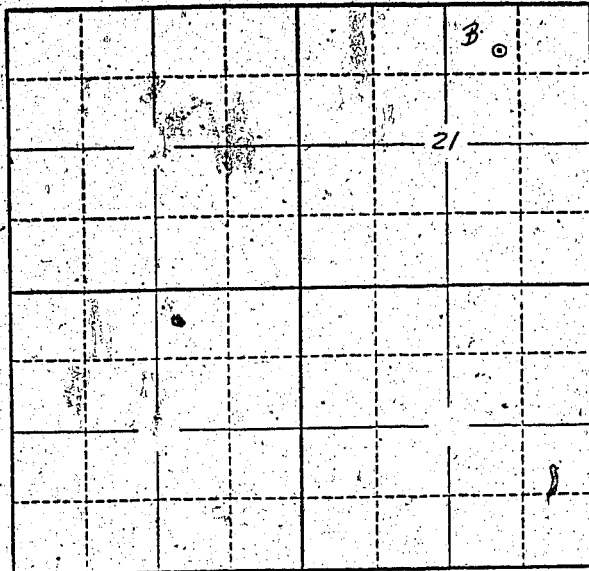

Locate well and acreage of irrigated land on plat.

Scale: 2" = 1 Mile

STATE OF OREGON

County of Marion } ss.

I, _____, being first duly sworn, do hereby certify that I have read the foregoing Registration Statement and that all of the items therein contained are true to the best of my knowledge and belief.

Sam L. Hightlinger
(Signature of Registrant)

Subscribed and sworn to before me this 10th day of July, 19 58

My commission expires 12th June 1961 Wm. S. Bartholomew
(Notary Public)

(SEAL)

CERTIFICATE OF REGISTRATION

STATE OF OREGON

County of Marion } ss.

This is to certify that the foregoing Registration Statement was received in the office of the State Engineer on the 10th day of July, 19 58, at 4:40 o'clock P. M. and has been duly recorded in said office in Book No. 9 of Registration Statements on page GR-1978

Witness my hand this 9th day of February, 19 59

Lewis A. Stanley
(State Engineer)

\$ 15.00

By _____ (Deputy)

GR - 1978