

Registration Statement

OF CLAIMANT OF RIGHT TO APPROPRIATE GROUND WATER

TO THE STATE ENGINEER OF OREGON:

I, Ward C Russell

of RR 2 Box 106 County of Marion

State of Oreg, do hereby make application for a certificate of registration as evidence of a right to appropriate ground water.

1. Source from which water is withdrawn is Pump Well
(Flowing well, pump well, infiltration trench, or tunnel)

2. Location is: 1 1/2 mi N.W. Aurora
(Approximate distance and direction from nearest city or town)

and is more particularly described as follows:

(a) 286 feet 1260 feet south, 125 feet west 165 feet W
NE 1/4 of NW 1/4 (Give distance and bearing to corner of section or other legal subdivision)
from N 1/4 corner Section 11

being within N.W. Quarter of Sec. 11, Twp. 4 S, Rge. 1 W
(Smallest legal subdivision) (N. or S.) (E. or W.)

or (b) within limits of recorded platted property, town or city: not in a city
in Lot _____, Block _____ of _____
(Name of plat or addition)

County of _____
(If within city or town, give name)
3. Construction Work was begun on Sept 5, 46, was completed on Sept. 10, 46
(Date) (Date)

and the ground water claimed was first used for the purposes set out below on Sept 46
(Date)
since which time the water has been used intermittently
(Continuously or intermittently)

from May 1 to Oct 1
(Date) (Date)

4. Quantity of water claimed and used is 100 gallons per minute; _____ acre
feet per year.

5. Purpose or Purposes for which water is used Irrigation

(Domestic, irrigation, municipal, manufacturing, industrial, etc.)

6. Description of Well: Depth 123 feet. Type Drilled
(Dug or drilled)

diameter 6 inches. Elevation of ground at well site 194 feet, mean sea level.
(As near as known)

Depth to water table 60 feet.

7. Capacity of Well: 60 g.p.m. with _____ feet drawdown.
_____ g.p.m. with _____ feet drawdown.

Date of test _____

If Flowing Well: Measured discharge _____ g.p.m. on _____
(Date)

Shut-in pressure at ground surface _____ lbs. per sq. in. on _____
(Date)

Water is controlled by Open Flowing Well
(Cap, valve, etc.)

8. Casing: (Give diameter, commercial specifications and depth below ground surface of each casing size.)

6 inch diameter From Ground Level ~~to~~ 0 to 123 feet
_____ inch diameter _____ from _____ to _____ feet
_____ inch diameter _____ from _____ to _____ feet
_____ inch diameter _____ from _____ to _____ feet

Describe and show depth of shoe, plug, adapter, liner or other details: _____

9. Perforated Casings or Screens:

yes _____ from unk to _____
(Number per foot and size of perforations, or describe screen)
_____ from _____ to _____
_____ from _____ to _____
_____ from _____ to _____

10. Log of Well: (Describe each stratum or formation clearly, indicate if water bearing, and give thickness and depth as indicated.)

MATERIAL	Thickness (Feet)	Depth to Bottom (Feet)
sand & gravel		

If log of well is not available, give name and address of driller.

JT Miller

Aurora Ore

11. Infiltration Trench: Covered or open

Dimensions: Length ft. Minimum depth ft. Maximum depth ft.

Bottom width ft. Discharge g.p.m. Date of test

12. Tunnel: Type of lining

Dimensions: (Length, course, and cross sectional size)

Position of water bearing stratum with reference to portal of tunnel

Log of tunnel: (Preceding table for log of well may be used, if desired. Give footage from portal and character of materials, as pertinent.)

13. Pumping Equipment:

(a) Pump Cook, Turbine Capacity 100 g.p.m. (Make, type and size)


(b) Motor Single Phase 3 (Type and horsepower)

14. Location of area irrigated or to be irrigated, or place of use if for purposes other than irrigation

Township North or South	Range E. or W. of Williamsite Meridian	Section	Forty-acre Tract	Number Acres To Be Irrigated	Date of Reclamation
4 S	1 W	11	NE 1/4 of NW 1/4	11	Sept 5 46
4 S	1 W	11	SE 1/4 of NW 1/4	10	Sept 5 46
4 S	1 W	11	SW 1/4 of NW 1/4	5	Sept 46
4 S	1 W	11	NW 1/4 of NW 1/4	5 1/2	Sept 46
				31 1/2 Ac	

15. If the ground water supply is supplemental to an existing water supply, identification of any application for a permit, permit, certificate or adjudicated right to appropriate water made or held by the registrant.

Township 15 Range 11, W.M.
North

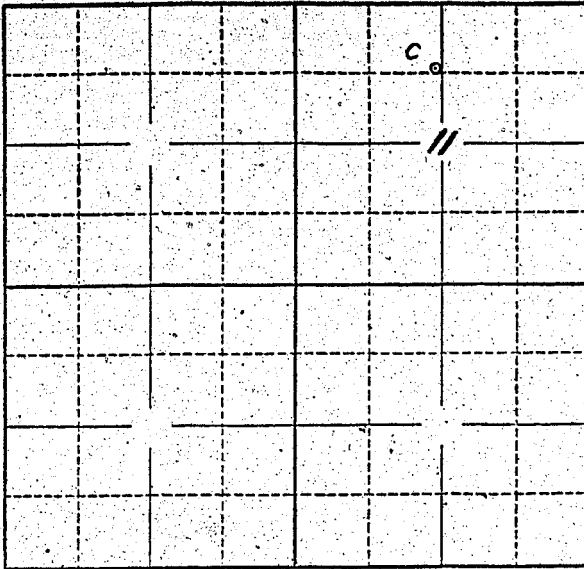

Locate well and acreage of irrigated land on plat.
Scale: 2" = 1 Mile

STATE OF OREGON

County of Marion } ss.

I, _____, being first duly sworn, do hereby certify that I have read the foregoing Registration Statement and that all of the items therein contained are true to the best of my knowledge and belief.

Hard Russell
(Signature of Registrant)

Subscribed and sworn to before me this 10th day of July, 19 58

My commission expires 12th June 1961 Wm. S. Bartholomew
(Notary Public)

(SEAL)

CERTIFICATE OF REGISTRATION

STATE OF OREGON

County of Marion } ss.

This is to certify that the foregoing Registration Statement was received in the office of the State Engineer on the 10th day of July, 19 58, at 2:00 o'clock P. M. and has been duly recorded in said office in Book No. 9 of Registration Statements on page GR-1979

Witness my hand this 9th day of February, 19 59

Lewis A. Stanley
(State Engineer)

By _____ (Deputy)

\$ 15.30

GR-1979