

Registration No. GR. 2055
Certificate No. GR. 1981

Registration Statement

OF CLAIMANT OF RIGHT TO APPROPRIATE GROUND WATER

TO THE STATE ENGINEER OF OREGON:

I, Edward Willers
of 2065 N.W. Glencoe, Hillsboro County of Washington
(Mailing address)
State of Oregon, do hereby make application for a certificate of registration as evidence of a right to appropriate ground water.

1. Source from which water is withdrawn is pump well
(Flowing well, pump well, infiltration trench, or tunnel)
2. Location is: 190' S 81° E from NW Corner Section 31 T1N R2W
(Approximate distance and direction from nearest city or town)

and is more particularly described as follows:

(a) 3/4 m. North of Hillsboro
(Give distance and bearing to corner of section or other legal subdivision)
being within NW 1/4 of NW 1/4 of Sec. 31, Twp. 1N, Rge. 2W
(Smallest legal subdivision) (N. or S.) (E. or W.)

or (b) within limits of recorded platted property, town or city:
in Lot _____, Block _____ of _____
(Name of plat or addition)
County of Washington
(If within city or town, give name)

3. Construction Work was begun on Oct. 1942; was completed on Oct 1942
(Date) (Date)
and the ground water claimed was first used for the purposes set out below on 1943
(Date)
since which time the water has been used Continuously
(Continuously or Intermittently)
from 1943 to 1958
(Date) (Date)

4. Quantity of water claimed and used is 5 gallons per minute; _____ acre feet per year.

5. Purpose or Purposes for which water is used Domestic and irrigation
(Domestic, irrigation, municipal, manufacturing, industrial, etc.)

6. Description of Well: Depth 45 feet. Type drilled
(Dug or drilled)
diameter 6 inches. Elevation of ground at well site 200 feet, mean sea level.
(As near as known)
Depth to water table 25 feet.

7. Capacity of Well: 5 g.p.m. with 25 feet drawdown.
_____ g.p.m. with _____ feet drawdown.

Date of test October 1942


If Flowing Well: Measured discharge _____ g.p.m. on _____
(Date)

Shut-in pressure at ground surface _____ lbs. per sq. in. on _____
(Date)

Water is controlled by _____
(Cap, valve, etc.)

Township 1N Range 2W, W.M.

North

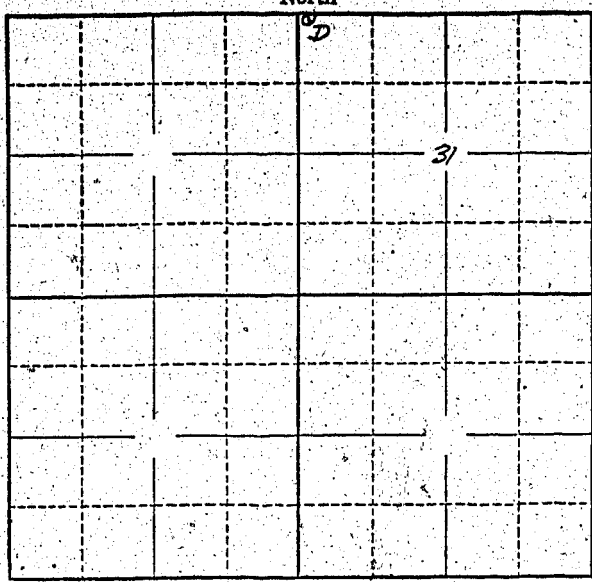

Locate well and acreage of irrigated land on plat.
Scale: 2" = 1 Mile

STATE OF OREGON }
County of Marion } ss.

I, _____, being first duly sworn, do hereby certify that I have read the foregoing Registration Statement and that all of the items therein contained are true to the best of my knowledge and belief.

Edward W. Sellers
(Signature of Registrant)

Subscribed and sworn to before me this 7th day of July, 1958

My commission expires 12th June 1961 Wm. S. Bartholomew
(Notary Public)

(SEAL)

CERTIFICATE OF REGISTRATION

STATE OF OREGON }
County of Marion } ss.

This is to certify that the foregoing Registration Statement was received in the office of the State Engineer on the 11th day of July, 1958, at 8:00 o'clock AM and has been duly recorded in said office in Book No. 9 of Registration Statements on page GR1981

Witness my hand this 9th day of February, 1959

Lewis A. Stanley
(State Engineer)

By _____
(Deputy)

15.00

GR-1981