

# Registration Statement

## OF CLAIMANT OF RIGHT TO APPROPRIATE GROUND WATER

TO THE STATE ENGINEER OF OREGON:

I, LAWRENCE or LOUISE SZUKAI  
of Box 75 R. 1 Eugene County of Lane  
(Mailing address)

State of Oregon, do hereby make application for a certificate of registration as evidence of a right to appropriate ground water.

1. Source from which water is withdrawn is PUMP WELL  
(Flowing well, pump well, infiltration trench, or tunnel)

2. Location is: 6 MILES N.W. EUGENE  
(Approximate distance and direction from nearest city or town)

and is more particularly described as follows: 650 feet south & 1000 feet west from E 1/4 corner.

(a) 66 ft S & 97 ft W - OF DONATION LAND CLAIM-CORNER  
(Give distance and bearing to corner of section or other legal subdivision)

being within ~~SE 1/4 NE 1/4~~ of Sec. 3, Twp. 17S, Rge. 4 W.W.M.  
(Smallest legal subdivision) (S. or S.) (W. or W.)

or (b) within limits of recorded platted property, town or city:

in Lot \_\_\_\_\_, Block \_\_\_\_\_ of \_\_\_\_\_  
(If within city or town, give name) County of \_\_\_\_\_  
(Name of plat or addition)

3. Construction Work was begun on AUGUST 1, 1928; was completed on AUGUST 1, 1928,  
(Date) (Date)

and the ground water claimed was first used for the purposes set out below on AUGUST 1, 1928,  
(Date)

since which time the water has been used CONTINUOUSLY  
(Continuously or intermittently)

from AUGUST 1, 1928 to JULY 9, 1958  
(Date) (Date)

4. Quantity of water claimed and used is 50 gallons per minute; 2 1/2 ACRE FEET feet per year.

5. Purpose or Purposes for which water is used BARNYARD - IRRIGATION  
(Domestic, irrigation, municipal, manufacturing, industrial, etc.)

6. Description of Well: Depth 19 feet. Type DRIVE IN  
(Dug or drilled)

diameter 1 3/4 inches. Elevation of ground at well site 360 feet, mean sea level.  
(As near as known)

Depth to water table 12 feet.

7. Capacity of Well: 3000 g.p.m. with 1 1/2 feet drawdown.  
\_\_\_\_\_ g.p.m. with \_\_\_\_\_ feet drawdown.

Date of test JUNE 25 1958

If Flowing Well: Measured discharge \_\_\_\_\_ g.p.m. on \_\_\_\_\_  
(Date)


Shut-in pressure at ground surface \_\_\_\_\_ lbs. per sq. in. on \_\_\_\_\_  
(Date)

Water is controlled by \_\_\_\_\_  
(Cap, valve, etc.)





Township 17.5 Range 4 W W.M.  
North

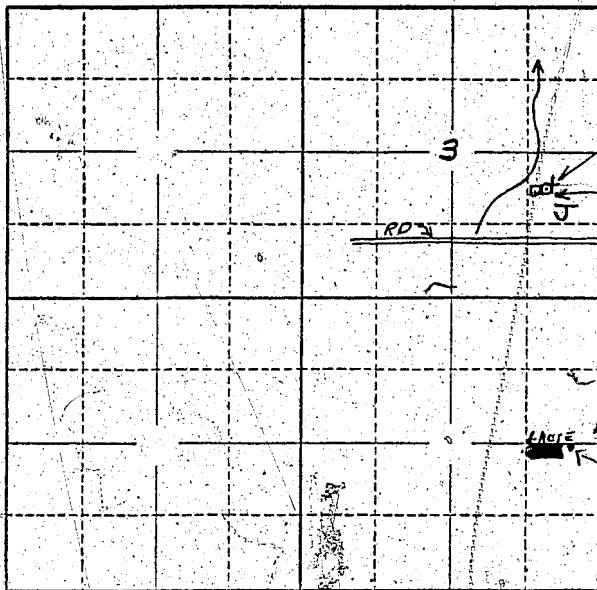

Locate well and acreage of irrigated land on plat.  
Scale: 2" = 1 Mile

STATE OF OREGON

County of Linn } ss.

I, LAWRENCE SENEKAI, being first duly sworn, do hereby certify that I have read the foregoing Registration Statement and that all of the items therein contained are true to the best of my knowledge and belief.

Lawrence Senekai  
(Signature of Registrant)

Subscribed and sworn to before me this 9th day of July, 1958

My commission expires Sept. 29, 1960 D. J. Young  
(Notary Public)

(SEAL)

**CERTIFICATE OF REGISTRATION**

STATE OF OREGON } ss.  
County of Marion

This is to certify that the foregoing Registration Statement was received in the office of the State Engineer on the 7th day of July, 1958, at                      o'clock            M. and has been duly recorded in said office in Book No. 16 of Registration Statements on page GR-3814

Witness my hand this 26 day of December, 1959

Laura A. Stanley  
(State Engineer)

By                       
(Deputy)

\$ 15.00