

RECEIVED
STATE ENGINEER
SALE

Registration No. GR-2058
Certificate No. GR-1983

Registration Statement

OF CLAIMANT OF RIGHT TO APPROPRIATE GROUND WATER

TO THE STATE ENGINEER OF OREGON:

(Mailing address)
State of Oregon, do hereby make application for a certificate of registration as evidence
of a right to appropriate ground water.

1. Source from which water is withdrawn is Flowing Well
(Flowing well, pump well, infiltration trench, or tunnel)
2. Location is: 1/2 mile North of Seaford, Ore.
(Approximate distance and direction from nearest city or town)

and is more particularly described as follows:

(a) 1150 feet South and 135 feet East from the 1/4
(Give distance and bearing to corner of section or other legal subdivision)
being within NE 1/4 of 1/4 of Sec. 1, Twp. 37E, Rge.
(Smallest legal subdivision) (N. or S.) (E. or W.)
or (b) within limits of recorded platted property, town or city:
in Lot , Block of
(Name of plat or addition)
County of
(If within city or town, give name)


(Date) (Date)

4. Quantity of water claimed and used is 100 gallons per minute; acre
feet per year.


5. Purpose or Purposes for which water is used Domestic
(Domestic, irrigation, municipal, manufacturing, industrial, etc.)



(Date)
Water is controlled by Cap. valve, etc.
(Cap. valve, etc.)

Township 37S Range 2W, W.M.
North

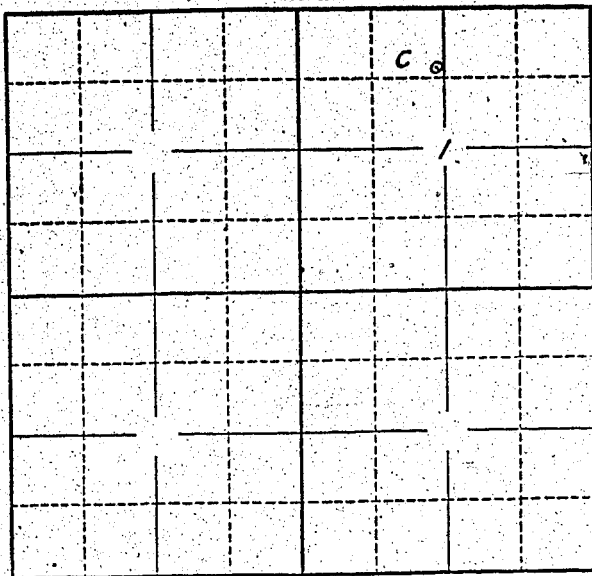

Locate well and acreage of irrigated land on plat.
Scale: 4' = 1 Mile

STATE OF OREGON

County of Jackson & L. Ella Gordon } ss.

I, Ronald R. Gordon, being first duly sworn, do hereby certify that I have read the foregoing Registration Statement and that all of the items therein contained are true to the best of my knowledge and belief.

Ronald R. Gordon
(Signature of Registrant)

Subscribed and sworn to before me this 10th day of July, 1959

My commission expires May 31 1962 [Signature]
(Notary Public)

(SEAL)

CERTIFICATE OF REGISTRATION

STATE OF OREGON

County of Marion } ss.

This is to certify that the foregoing Registration Statement was received in the office of the State Engineer on the 11th day of July, 1959, at 9:00 o'clock A.M. and has been duly recorded in said office in Book No. 9 of Registration Statements on page GR-1983

Witness my hand this 9th day of February, 1959

Lewis A. Stanley
(State Engineer)

By _____ (Deputy)

\$ 20⁰⁰