

Registration Statement**OF CLAIMANT OF RIGHT TO APPROPRIATE GROUND WATER**

(Under Chapter 708, Oregon Laws 1955.)

TO THE STATE ENGINEER OF OREGON:

I, Silas F. Berlich Atty, Box 221
Marion Brooks Oregon
 of _____ County of _____

State of Oregon, do hereby make application for a certificate of registration as evidence of a right to appropriate ground water.

1. Source from which water is withdrawn is Pump Well
(Flowing well, pump well, infiltration trench, or tunnel)

2. Location is: 9 miles from Salem
(Approximate distance and direction from nearest city or town)

and is more particularly described as follows: Chains Well is 568.37 E-33 ch. and
N 25° 10' E 50.51 ch from NE 1/4

(a) N. 68° 37' W. (26.43) Corner of D.L.C. 67
(Give distance and bearing to corner of section or other legal subdivision)

being within Plot 1/4 Sec 15 of Sec. 15 Twp. 6 S. Rge. 2 W WM
(Smallest legal subdivision) (N. or S.) (E. or W.)

or (b) within limits of recorded platted property, town or city: _____

in Lot _____ Block _____ of _____
(Name of plat or addition)

County of _____
(If within city or town, give name)

3. Construction Work was begun on Jan 2, 1951; was completed on Jan. 16, 1951
(Date) (Date)

and the ground water claimed was first used for the purposes set out below on irrigation Sept 1, 1951
(Date)

since which time the water has been used Continuously for domestic; intermittently irrig
(Continuously or intermittently)

from Jan. 1951 to Oct 1956
(Date) (Date)

4. Quantity of water claimed and used is 100 gallons per minute; 16 1/2 acre
 feet per year.

5. Purpose or Purposes for which water is used Domestic & irrigation

(Domestic, irrigation, municipal, manufacturing, industrial, etc.)

6. Description of Well: Depth 86 feet. Type Drilled
(Dug or drilled)

diameter 10 inches. Elevation of ground at well site _____ feet, mean sea level.
(As near as known)

Depth to water table 30 feet.

7. Capacity of Well: 165 g.p.m. with 84 feet drawdown.

_____ g.p.m. with _____ feet drawdown.

Date of test Sept 1st 1951

If Flowing Well: Measured discharge _____ g.p.m. on _____
(Date)

Shut-in pressure at ground surface _____ lbs. per sq. in. on _____
(Date)

Water is controlled by _____
(Cap, valve, etc.)

8. **Casing:** (Give diameter, commercial specifications and depth below ground surface of each casing size.)

10 inch diameter from 0 to 80 feet
 inch diameter from to feet
 inch diameter from to feet
 inch diameter from to feet

Describe and show depth of shoe, plug, adapter, liner or other details:

9. Perforated Casings or Screens:

not Perforated
(Number per foot and size of perforations, or d

from to

from to

from to

from to

10. Log of Well: (Describe each stratum or formation clearly, indicate if water bearing, and give thickness and depth as indicated.)

[illegible]

GR-191 A

R. Stadel

Dimensions: Length ft. Minimum depth ft. Maximum depth ft.

12. Tunnel: Type of lining : _____

(Length, course, and cross sectional size)

Position of water bearing stratum with reference to portal of tunnel

13. Pumping Equipment:

(Make, type and size)


(Type and horsepower)

[illegible]

15. If the ground water supply is supplemental to an existing water supply, identification of any application for a permit, permit, certificate or adjudicated right to appropriate water made or held by the registrant.

GR-191-B

Township 6 S Range 2 W W.M. /
North

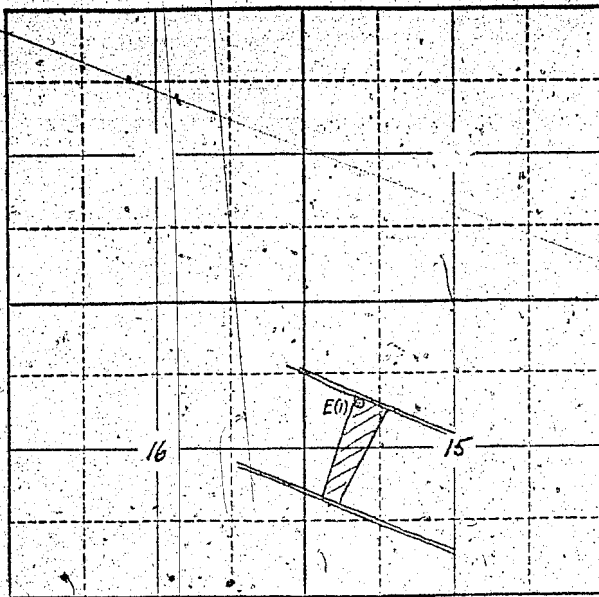

Locate well and acreage of irrigated land on plat.

Scale: 2" = 1 Mile

4

STATE OF OREGON

County of Marion

SS.

I, Silas F. Berlich, being first duly sworn, do hereby certify that I have read the foregoing Registration Statement and that all of the items therein contained are true to the best of my knowledge and belief.

Silas F. Berlich
(Signature of Registrant)

Subscribed and sworn to before me this 9th day of July, 1954

My commission expires February 1, 1954

Wm. Livingood
(Notary Public)

(SEAL)

CERTIFICATE OF REGISTRATION

STATE OF OREGON

County of Marion

SS.

This is to certify that the foregoing Registration Statement was received in the office of the State Engineer on the 13th day of July, 1956, at 10:30 o'clock A. M. and has been duly recorded in said office in Book No. 1 of Registration Statements on page GR-191 C.

~~Construction shall be completed by x-x-x-x-x-x-x-x-19-x-x and the water completely applied to beneficial use by x-x-x-x-x-x-x-x-19-x-x.~~

Witness my hand this 23rd day of November

1956

Leuro A. Stanley
(State Engineer)

By

(Deputy)

GR-191 C