

Well # 2

Registration No. GR. 2065

Certificate No. GR. 1987

Registration Statement

OF CLAIMANT OF RIGHT TO APPROPRIATE GROUND WATER

TO THE STATE ENGINEER OF OREGON:

I, Bill Peaches
of Independence, Or. 1 County of Polk
(Mailing address)

State of Or do hereby make application for a certificate of registration as evidence of a right to appropriate ground water.

1. Source from which water is withdrawn is Well #2
(Flowing well, pump well, infiltration trench, or tunnel)

2. Location is: 5 1/2 mi. S. Independence
(Approximate distance and direction from nearest city or town)

and is more particularly described as follows:

(a) 16.343 chains S. 90.36' W. from northeast corner of Sec. 14
(Give distance and bearing to corner of section or other legal subdivision)

(Smallest legal subdivision) (N. or S.) (E. or W.)

or (b) within limits of recorded platted property, town or city:

in Lot , Block of
(Name of plat or addition)

County of Polk
(If within city or town, give name)

3. Construction Work was begun on June - 1951; was completed on June - 1957
(Date) (Date)

and the ground water claimed was first used for the purposes set out below on June - 1957
(Date)

since which time the water has been used each year & intermittently
(Continuously or intermittently)

from June to Aug
(Date) (Date)

4. Quantity of water claimed and used is 500 gallons per minute; acre feet per year.

5. Purpose or Purposes for which water is used Irrigation

(Domestic, irrigation, municipal, manufacturing, industrial, etc.)

6. Description of Well: Depth 38 feet. Type Dug
(Dug or drilled)

diameter 10" inches. Elevation of ground at well site 140 feet, mean sea level.
(As near as known)

Depth to water table 17 feet.

7. Capacity of Well: 500 g.p.m. with 1/2 feet drawdown.

 g.p.m. with feet drawdown.


Date of test

If Flowing Well: Measured discharge g.p.m. on (Date)

Shut-in pressure at ground surface lbs. per sq. in. on (Date)

Water is controlled by Valve
(Cap, valve, etc.)

Township 9S Range 4W, W.M.
North

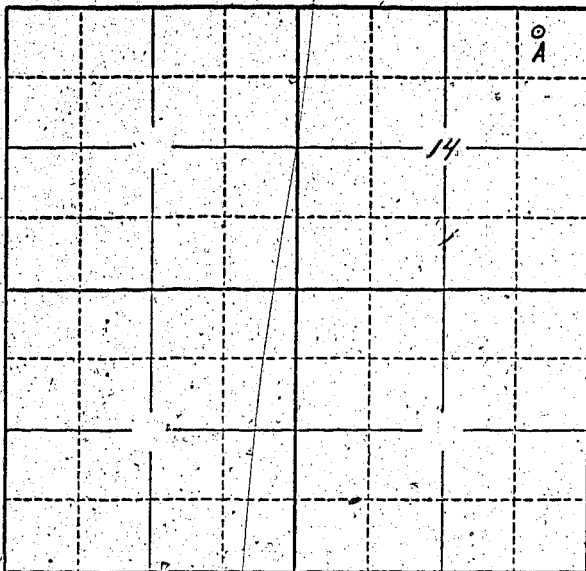

Locate well and acreage of irrigated land on plat.
Scale: 2" = 1 Mile

STATE OF OREGON

County of Marion } ss.

I, Gail Prather being first duly sworn, do hereby certify that I have read the foregoing Registration Statement and that all of the items therein contained are true to the best of my knowledge and belief.

Gail Prather
(Signature of Registrant)

Subscribed and sworn to before me this 11th day of July, 19 58

My commission expires 12th June 1961 Wm. S. Bartholmeis
(Notary Public)

(SEAL)

CERTIFICATE OF REGISTRATION

STATE OF OREGON } ss.
County of Marion

This is to certify that the foregoing Registration Statement was received in the office of the State Engineer on the 11th day of July, 19 58, at 10:30 o'clock P. M. and has been duly recorded in said office in Book No. 9 of Registration Statements on page GR 1987

Witness my hand this 9th day of February, 19 59

Lewis A. Stanley
(State Engineer)

By _____
(Deputy)

#1625