

Registration Statement

REGISTRATION NO. GR-207

CERTIFICATE NO. GR-192

OF CLAIMANT OF RIGHT TO APPROPRIATE GROUND WATER

(Under Chapter 708, Oregon Laws 1955.)

State # 1

TO THE STATE ENGINEER OF OREGON:

I, Leland W Wells
of Jefferson County of Marion
State of Oregon, do hereby make application for a certificate of registration as evidence of a right to appropriate ground water.

1. Source from which water is withdrawn is Pump Wells
(Flowing well, pump well, infiltration trench, or tunnel)

2. Location is: 1 Mi So Jefferson
(Approximate distance and direction from nearest city or town)

and is more particularly described as follows:

(a) 1000' feet south and 750' feet east from the NW corner of section 19
(Give distance and bearing to corner of section or other legal subdivision)
being within NW 1/4 of NW 1/4 of Sec. 13, Twp. 10S, Rge. 3W
(Smallest legal subdivision) (N. or S.) (E. or W.)

or (b) within limits of recorded platted property, town or city:

in Lot _____, Block _____ of _____
(Name of plat or addition)

County of _____
(If within city or town, give name)

3. Construction Work was begun on June 1937 was completed on June 1937
(Date) (Date)

and the ground water claimed was first used for the purposes set out below on June 1937
(Date)

since which time the water has been used Continuously during season
(Continuously or Intermittently)

from June 1937 to July 19, 1966
(Date) (Date)

4. Quantity of water claimed and used is 2600 gallons per minute; _____ acre feet per year.

5. Purpose or Purposes for which water is used Irrigation
(Domestic, irrigation, municipal, manufacturing, industrial, etc.)

6. Description of Well: Depth 30 feet. Type Drilled
(Dug or drilled)

diameter 8 inches. Elevation of ground at well site 260 feet, mean sea level.
(As near as known)

Depth to water table 15 feet. 7/1/50

7. Capacity of Well: _____ g.p.m. with _____ feet drawdown.

_____ g.p.m. with _____ feet drawdown.

Date of test No Test

If Flowing Well: Measured discharge _____ g.p.m. on _____
(Date)

Shut-in pressure at ground surface _____ lbs. per sq. in. on _____
(Date)

Water is controlled by _____
(Cap, valve, etc.)

8	inch diameter	steel, casing	from	0	to	30	feet
	inch diameter		from		to		feet
	inch diameter		from		to		feet
	inch diameter		from		to		feet

Describe and show depth of shoe, plug, adapter, liner or other details:

UNKNOWN

(Number per foot and size of perforations, or describe screen)

10. **Log of Well:** (Describe each stratum or formation clearly, indicate if water bearing, and give thickness and depth as indicated.)

[illegible]

If log of well is not available, give name and address of driller. R. A. West - Marion West

11. Infiltration Trench: Covered or open

Dimensions: Length ft. Minimum depth ft. Maximum depth ft.

Bottom width ft. Discharge g.p.m. Date of test

12. Tunnel: Type of lining

Dimensions: _____ (Length, course, and cross sectional size)

Position of water bearing stratum with reference to portal of tunnel

Log of tunnel: (Preceding table for log of well may be used, if desired. Give footage from portal and character of materials, as pertinent.)

13. Pumping Equipment:

(a) Pump Centrifugal Capacity 300 g.p.m.
(Make, type and size)

(b) Motor 10 H.P. Elect.
(Type and horsepower)


14. Location of area irrigated or to be irrigated, or place of use if for purposes other than irrigation.

[illegible]

15. If the ground water supply is supplemental to an existing water supply, identification of any application for a permit, permit, certificate or adjudicated right to appropriate water made or held by the registrant.

See
Enclosed
Map

Township Range W.M.
North

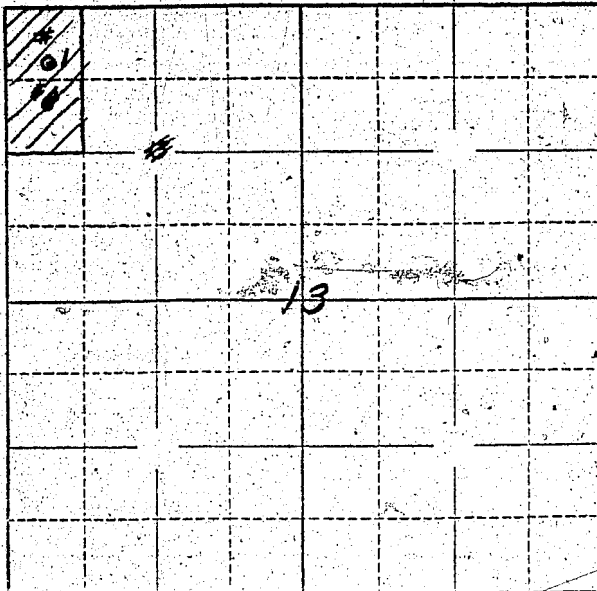

Locate well and acreage of irrigated land on plat.

Scale: $\frac{1}{4}$ " = 1 Mile

STATE OF OREGON

County of

ss.

I,, being first duly sworn, do hereby certify that I have read the foregoing Registration Statement and that all of the items therein contained are true to the best of my knowledge and belief.

(Signature of Registrant)

Subscribed and sworn to before me this day of, 19.....

My commission expires

(Notary Public)

(SEAL)

FOR CERTIFICATE SEE PAGE GR-192 O
CERTIFICATE OF REGISTRATION

STATE OF OREGON

County of Marion

ss.



Witness my hand this day of, 19.....

(State Engineer)

By

(Deputy)

GR-192 C

Registration Statement

REGISTRATION NO. GR-207

CERTIFICATE NO. GR-192

OF CLAIMANT OF RIGHT TO APPROPRIATE GROUND WATER

(Under Chapter 708, Oregon Laws 1955.)

Site # 2

TO THE STATE ENGINEER OF OREGON:

I, Leland W Wells
of Jefferson County of Marion
State of Oregon, do hereby make application for a certificate of registration as evidence of a right to appropriate ground water:

1. Source from which water is withdrawn is Pump Wells #2
(Flowing well, pump well, infiltration trench, or tunnel)
2. Location is: 1 mi So Jefferson
(Approximate distance and direction from nearest city or town)

and is more particularly described as follows:

(a) 2600 ft south and 20 feet west from NE corner, section 14
(Give distance and bearing to corner of section or other legal subdivision)
being within SE 1/4 of NE 1/4 of Sec. 14, Twp. 10 S, Rge. 3 W
(Smallest legal subdivision) (N. or S.) (E. or W.)

or (b) within limits of recorded platted property, town or city:

in Lot _____, Block _____ of _____
(Name of plat or addition)
County of _____
(If within city or town, give name)

3. Construction Work was begun on July 1940, was completed on July 1940
(Date) (Date)
and the ground water claimed was first used for the purposes set out below on July 1940
(Date)
since which time the water has been used Cont.
(Continuously or intermittently)

from _____ to _____
(Date) (Date)

4. Quantity of water claimed and used is 300 gallons per minute; _____ acre feet per year.

5. Purpose or Purposes for which water is used Irrigation
(Domestic, irrigation, municipal, manufacturing, industrial, etc.)

6. Description of Well: Depth 2.5 feet. Type Drilled
(Dug or drilled)
diameter 8 inches. Elevation of ground at well site 260 feet, mean sea level.
(As near as known)
Depth to water table 10 feet.

7. Capacity of Well: _____ g.p.m. with _____ feet drawdown.
_____ g.p.m. with _____ feet drawdown.

Date of test W test

If Flowing Well: Measured discharge _____ g.p.m. on _____
(Date)

Shut-in pressure at ground surface _____ lbs. per sq. in. on _____
(Date)

Water is controlled by _____
(Cap, valve, etc.)

GR-192 D

inch diameter unknown from 0 to 0 feet

inch diameter _____ from _____ to _____ feet

inch diameter _____ from _____ to _____ feet

inch diameter _____ from _____ to _____ feet


Describe and show depth of shoe, plug, adapter, liner or other details:

unknown from to
(Number per foot and size of perforations, or describe screen) from to
from to
from to
from to

10. **Log of Well:** (Describe each stratum or formation clearly, indicate if water bearing, and give thickness and depth as indicated.)

[illegible]

See Enclosed Map.

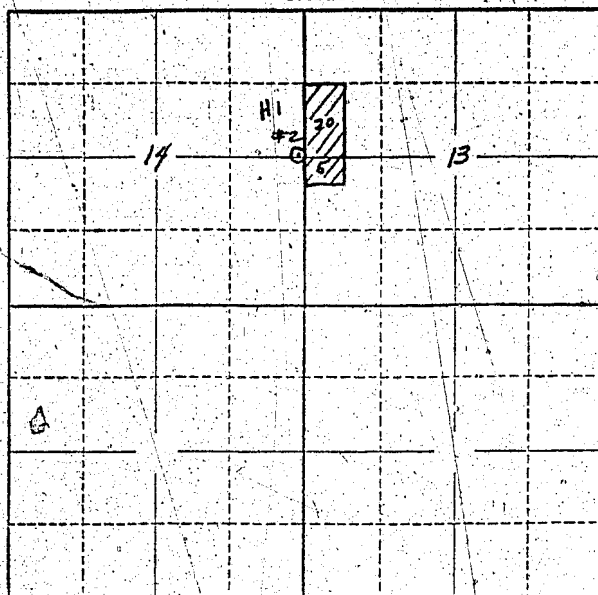

Scale: 2" = 1 Mile

County of _____

(Signature of Registrant)

My commission expires

(Notary Public)

FOR CERTIFICATE SEE PAGE GR-192 O
~~CERTIFICATE OF REGISTRATION~~

County of Marion

~~Construction shall be completed by X-X-X-X-X-X-X-X-19-X-X, and the same simplicity applied to~~

~~X-X-X-X-X-X-X-X-X-X-X-X-X-X-X-X-X-X-~~

(State Engineer)

By _____ (Deputy)

GR-192 G

Registration Statement

REGISTRATION NO. GR-207CERTIFICATE NO. GR-192

OF CLAIMANT OF RIGHT TO APPROPRIATE GROUND WATER

(Under Chapter 708, Oregon Laws 1955.)

Site # 3

TO THE STATE ENGINEER OF OREGON:

I, Leland W Wells
of Jefferson County of Marion
State of Oregon, do hereby make application for a certificate of registration as evidence
of a right to appropriate ground water.

1. Source from which water is withdrawn is Pump Well #3
(Flowing well, pump well, infiltration trench, or tunnel)
2. Location is: 1 M. S. Jefferson
(Approximate distance and direction from nearest city or town)

and is more particularly described as follows:

- (a) 31.00 feet south and 750 feet west from NE corner section 14
(Give distance and bearing to corner of section or other legal subdivision)
- being within SE 1/4 of NE 1/4 of Sec. 14, Twp. 10 S., Rge. 3 W.
(Smallest legal subdivision) (N. or S.) (E. or W.)
- or (b) within limits of recorded platted property, town or city:
- in Lot _____, Block _____ of _____
(Name of plat or addition)

(If within city or town, give name)

County of _____

3. Construction Work was begun on July 1941 was completed on July 1941
(Date) (Date)
- and the ground water claimed was first used for the purposes set out below on July 1941
(Date)
- since which time the water has been used Cont.
(Continuously or intermittently)
- from July 5, 1941 to July 18, 1956
(Date) (Date)

4. Quantity of water claimed and used is 300 gallons per minute; _____ acre
feet per year.

5. Purpose or Purposes for which water is used Irrigation

(Domestic, irrigation, municipal, manufacturing, industrial, etc.)

6. Description of Well: Depth 28 feet. Type Drilled
(Dug or drilled)
- diameter 8 inches. Elevation of ground at well site 260 feet, mean sea level.
(As near as known)
- Depth to water table 12 feet.

7. Capacity of Well: _____ g.p.m. with _____ feet drawdown.
_____ g.p.m. with _____ feet drawdown.

Date of test No TestIf Flowing Well: Measured discharge _____ g.p.m. on _____
(Date)Shut-in pressure at ground surface _____ lbs. per sq. in. on _____
(Date)Water is controlled by _____
(Cap, valve, etc.)

GR-192 H

8. Casing: (Give diameter, commercial specifications and depth below ground surface of each casing size.)

8 inch diameter *steel casing* from 0 to 28 feet
 inch diameter from to feet
 inch diameter from to feet
 inch diameter from to feet

Describe and show depth of shoe, plug, adapter, liner or other details:

9. Perforated Casings or Screens:

<i>un known</i> (Number per foot and size of perforations, or describe screen)	* from from from from	to to to to
--	---	---

10. **Log of Well:** (Describe each stratum or formation clearly, indicate if water bearing, and give thickness and depth as indicated.)

[illegible]

If log of well is not available, give name and address of driller. Marion West

Marion West

11. Infiltration Trench: Covered or open

Dimensions: Length _____ ft. Minimum depth _____ ft. Maximum depth _____ ft.

Bottom width ft. Discharge g.p.m. Date of test

12. Tunnel: Type of lining

Dimensions: _____ (Length, course, and cross sectional size)

Position of water bearing stratum with reference to portal of tunnel

Log of tunnel: (Preceding table for log of well may be used, if desired. Give footage from portal and character of materials, as pertinent.)

13. Pumping Equipment:

(a) Pump centrifugal Capacity 300 g.p.m.
(Make, type and size)

(b) Motor 10 HP.
(Type and horsepower)


14. Location of area irrigated or to be irrigated, or place of use if for purposes other than irrigation.

[illegible]

15. If the ground water supply is supplemental to an existing water supply, identification of any application for a permit, permit, certificate or adjudicated right to appropriate water made or held by the registrant.

See Inclosed Map

Township 10S Range 3W W.M.
North

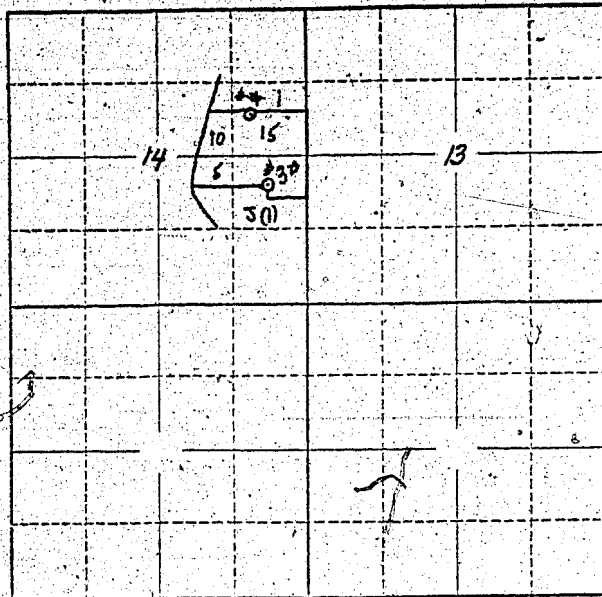

Locate well and acreage of irrigated land on plat.

Scale: 2" = 1 Mile

STATE OF OREGON

County of _____

ss.

I, _____, being first duly sworn, do hereby certify that I have read the foregoing Registration Statement and that all of the items therein contained are true to the best of my knowledge and belief.

(Signature of Registrant)

Subscribed and sworn to before me this _____ day of _____, 19____.

My commission expires _____

(Notary Public)

(SEAL)

FOR CERTIFICATE SEE PAGE GR-192 Q
CERTIFICATE OF REGISTRATION

STATE OF OREGON

County of Marion

ss.

This is to certify that the foregoing Registration Statement was received in the office of the State Engineer on the _____ day of _____, 19____, and that the same has been duly recorded in said office in Book _____ of the Registration Statements on page _____ of said book. The same was compiled by _____, 19____, and the same was properly applied to the beneficial use of _____.

Witness my hand this _____ day of _____, 19____.

(State Engineer)

By _____

(Deputy)

GR-192 K

Registration Statement

REGISTRATION NO. GR-207

CERTIFICATE NO. GR-192

OF CLAIMANT OF RIGHT TO APPROPRIATE GROUND WATER

(Under Chapter 703, Oregon Laws 1955.)

Site # 4

TO THE STATE ENGINEER OF OREGON:

I, Leland W Wells
of Jefferson County of Marion
State of Oregon, do hereby make application for a certificate of registration as evidence
of a right to appropriate ground water.

1. Source from which water is withdrawn is Pump Well #4
(Flowing well, pump well, infiltration trench, or tunnel)

2. Location is: _____
(Approximate distance and direction from nearest city or town)

and is more particularly described as follows:

(a) 1900 feet south and 960 feet west from NE corner of Section 14
(Give distance and bearing to corner of section or other legal subdivision)

being within SE 1/4 of NE 1/4 of Sec. 13, Twp. 10 S, Rge. 3 W
(Smallest legal subdivision) (N. or S.) (E. or W.)

or (b) within limits of recorded platted property, town or city: _____

in Lot _____, Block _____ of _____
(Name of plat or addition)

(If within city or town, give name) County of _____

3. Construction Work was begun on July 17, 1955 was completed on July 20, 1955
(Date) (Date)

and the ground water claimed was first used for the purposes set out below on July 25, 1955
(Date)

since which time the water has been used Cont.
(Continuously or Intermittently)

from July 1955 to July 18, 1956
(Date) (Date)

4. Quantity of water claimed and used is 300 gallons per minute; _____ acre
feet per year.

5. Purpose or Purposes for which water is used Irrigation
(Domestic, irrigation, municipal, manufacturing, industrial, etc.)

6. Description of Well: Depth 30 feet. Type Dug
(Dug or drilled)

diameter 8 inches. Elevation of ground at well site 260 feet, mean sea level.
(As near as known)

Depth to water table 14 feet.

7. Capacity of Well: _____ g.p.m. with _____ feet drawdown.

_____ g.p.m. with _____ feet drawdown.

Date of test No Test

If Flowing Well: Measured discharge _____ g.p.m. on _____
(Date)

Shut-in pressure at ground surface _____ lbs. per sq. in. on _____
(Date)

Water is controlled by _____
(Cap, valve, etc.)

GR-192 L

8. **Casing:** (Give diameter, commercial specifications and depth below ground surface of each casing size.)

8 inch diameter *steel casing* from 0 to 30 feet

Describe and show depth of shoe, plug, adapter, liner or other details: _____

9. Perforated Casings or Screens:

411 Known


(Number per foot and size of perforations, or describe screen)

from _____ to _____

from _____ to _____

from _____ to _____

from _____ to _____

 

10. Log of Well: (Describe each stratum or formation clearly, indicate if water bearing, and give thickness and depth as indicated.)

[illegible]

Marion West

11. Infiltration Trench: Covered or open

Dimensions: Length ft. Minimum depth ft. Maximum depth ft.

Bottom width ft. Discharge g.p.m. Date of test

12. Tunnel: Type of lining

Dimensions: _____
(Length, course, and cross sectional size)

Position of water bearing stratum with reference to portal of tunnel

Log of tunnel: (Preceding table for log of well may be used, if desired. Give footage from portal and character of materials, as pertinent.)

13. Pumping Equipment:

(a) Pump Centrifugal Capacity 300 g.p.m.
(Make, type and size)

(b) Motor 10 H.P.
(Type and horsepower)

14. Location of area irrigated or to be irrigated, or place of use if for purposes other than irrigation.

[illegible]

15. If the ground water supply is supplemental to an existing water supply, identification of any application for a permit, permit, certificate or adjudicated right to appropriate water made or held by the registrant.

GR-192 N

GR-1920