

RECEIVED  
JUL 14 1953  
STATE ENGINEER  
DAVEN OREGON

Registration No. GR. - 2071

Certificate No. GR. - 1885

# Registration Statement

## OF CLAIMANT OF RIGHT TO APPROPRIATE GROUND WATER

TO THE STATE ENGINEER OF OREGON:

We, The Oregonian Publishing Company

of 1320 S. W. Broadway County of Multnomah  
(Mailing address)

State of Oregon, do hereby make application for a certificate of registration as evidence of a right to appropriate ground water.

1. Source from which water is withdrawn is Pump Well # 3  
(Flowing well, pump well, infiltration trench, or tunnel)

2. Location is: \_\_\_\_\_  
(Approximate distance and direction from nearest city or town)

and is more particularly described as follows:

88' North of SW corner Block 185 (corner Broadway & Columbia) and  
(a) 12' West of property line (under sidewalk)  
(Give distance and bearing to corner of section or other legal subdivision)

being within Subj of NW 1/4 of Sec. 3, Twp. 15, Rge. 1E  
(Smallest legal subdivision) (N or S) (E or W)

or (b) within limits of recorded platted property, town or city: \_\_\_\_\_

in Lot 1 to 8, Block 185 of Portland  
(Name of plat or addition)

Portland County of Multnomah  
(If within city or town, give name)

3. Construction Work was begun on \_\_\_\_\_; was completed on January 7, 1948  
(Date) (Date)

and the ground water claimed was first used for the purposes set out below on May 15, 1948  
(Date)

since which time the water has been used continuously  
(Continuously or intermittently)

from May 15, 1948 to present date  
(Date) (Date)

4. Quantity of water claimed and used is 100 gallons per minute; \_\_\_\_\_ acre feet per year.

5. Purpose or Purposes for which water is used Air Conditioning building  
Industrial  
(Domestic, irrigation, municipal, manufacturing, industrial, etc.)

6. Description of Well: Depth 930 feet. Type Drilled  
(Dug or drilled)

diameter 16 inches. Elevation of ground at well site 98 feet, mean sea level.  
(As near as known)

Depth to water table 86 feet.

7. Capacity of Well: 500 g.p.m. with 160 feet drawdown.  
\_\_\_\_\_ g.p.m. with \_\_\_\_\_ feet drawdown.

Date of test Unknown

If Flowing Well: Measured discharge \_\_\_\_\_ g.p.m. on \_\_\_\_\_  
(Date)

Shut-in pressure at ground surface \_\_\_\_\_ lbs. per sq. in. on \_\_\_\_\_  
(Date)

Water is controlled by \_\_\_\_\_  
(Cap., valve, etc.)

8. Casing: (Give diameter, commercial specifications and depth below ground surface of each casing size.)

16 inch diameter standard steel pipe from ground to 198'5" feet  
 12 inch diameter " " " from 193 to 390 feet  
 inch diameter from to feet  
 inch diameter from to feet

Describe and show depth of shoe, plug, adapter, liner or other details:

9. Perforated Casings or Screens:

Not available from to  
 (Number per foot and size of perforations, or describe screen)  
 from to  
 from to  
 from to


10. Log of Well: (Describe each stratum or formation clearly, indicate if water bearing, and give thickness and depth as indicated.)

MATERIAL	Thickness (Feet)	Depth to Bottom (Feet)
Dry silt and sand	03	
Cemented gravel	41	
Sand and gravel with some water	13	
Cemented gravel	33	
Water bearing sand and gravel--various colors	21	
Black sand	2	
Cemented gravel	5	
Water bearing sand and gravel	25	
Gravel with clay binder	3	
Hard grey rock	34	
Yellow softer rock	27	
Hard grey rock	19	
Softer green rock	41	
Harder black rock	10	
Conglomerate containing some wood	3	
Harder grey rock	30	
Very hard grey rock	55	
Soft grey rock	28	
Grey conglomerate	6	
Soft grey rock	15	
Hard grey rock	5	
Very hard grey rock	11	
Soft porous black rock	36	
Fairly hard grey rock	33	
Soft black rock	16	
Fairly hard grey rock	55	
Very hard grey rock	40	
Softer black rock	65	
Harder black rock	7	
Soft black rock--water bearing formation	12	
Hard grey rock	8	
Soft black rock	1	
Hard grey rock	5	
Soft black rock	7	
Soft red rock	10	
Harder red rock	13	
Caving formation, black rock with red deposit on seams--	27	
This formation carries water		
Hard grey rock	5	

GR. 1885



Township 15 Range 1E W.M.  
North

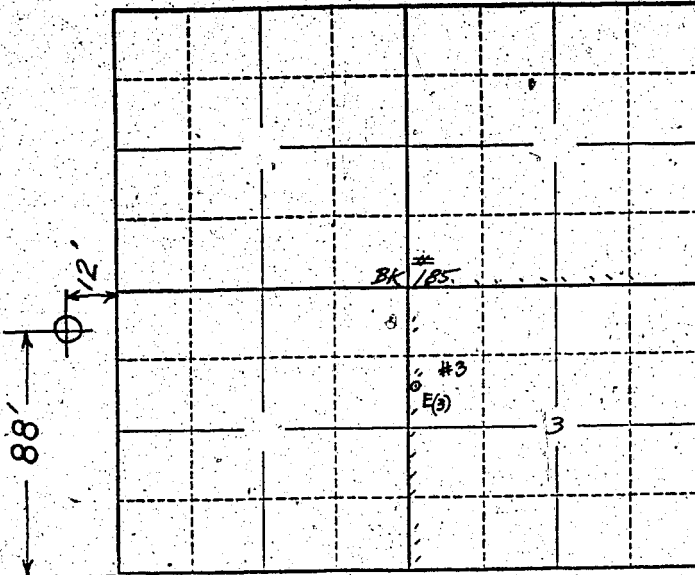

Locate well and acreage of irrigated land on plat.  
Scale: 2" = 1 Mile

STATE OF OREGON

County of Multnomah } ss.

I, James A. Melvin, being first duly sworn, do hereby certify that I have read the foregoing Registration Statement and that all of the items therein contained are true to the best of my knowledge and belief.

James A. Melvin Reg. Supt.  
(Signature of Registrant)

Subscribed and sworn to before me this 2 day of July, 1958

My commission expires 8/10/58  
J.R. Remenick  
(Notary Public)

(SEAL)

**CERTIFICATE OF REGISTRATION**

STATE OF OREGON

County of Marion } ss.

This is to certify that the foregoing Registration Statement was received in the office of the State Engineer on the 11th day of July, 1958, at 1:00 o'clock P. M. and has been duly recorded in said office in Book No. 9 of Registration Statements on page GR-1885

Witness my hand this 26th day of January, 1959  
Laura A. Stanley  
(State Engineer)

By \_\_\_\_\_ (Deputy)

GR-1885

\$ 20.00