

RECEIVED  
MAY 11 1948  
STATE ENGINEER  
SALEM, OREGON

Registration No. GR-2012

Certificate No. GR-1886

# Registration Statement

## OF CLAIMANT OF RIGHT TO APPROPRIATE GROUND WATER

TO THE STATE ENGINEER OF OREGON:

We,

I, The Oregonian Publishing Company

of 1320 S. W. Broadway County of Multnomah  
(Mailing address)

State of Oregon, do hereby make application for a certificate of registration as evidence of a right to appropriate ground water.

1. Source from which water is withdrawn is Pump Well  
(Flowing well, pump well, infiltration trench, or tunnel)

2. Location is: \_\_\_\_\_  
(Approximate distance and direction from nearest city or town)

and is more particularly described as follows:

(a) 63' West of SE corner of Block 185 (corner SW Sixth & Columbia) and  
6' South of property line (under sidewalk)  
(Give distance and bearing to corner of section or other legal subdivision)

being within Sublot NW 1/4 of Sec. 3 Twp. 15 Rge. 1 E  
(Smallest legal subdivision) (N. or S.) (E. or W.)

or (b) within limits of recorded platted property, town or city: \_\_\_\_\_

in Lot 1 to 3, Block 185 of Portland  
(Name of plat or addition)

Portland County of Multnomah  
(If within city or town, give name)

3. Construction Work was begun on \_\_\_\_\_ was completed on June 5, 1947  
(Date) (Date)

and the ground water claimed was first used for the purposes set out below on May 15, 1948  
(Date)

since which time the water has been used continuously  
(Continuously or intermittently)

from May 15, 1948 to present date  
(Date) (Date)

4. Quantity of water claimed and used is 100 gallons per minute; \_\_\_\_\_ acre feet per year.

5. Purpose or Purposes for which water is used Air Conditioning building

Industrial  
(Domestic, irrigation, municipal, manufacturing, industrial, etc.)

6. Description of Well: Depth 103 feet. Type Drilled  
(Dug or drilled)  
diameter 1 1/4 inches. Elevation of ground at well site 95 feet, mean sea level.  
(As near as known)

Depth to water table 61 feet.

7. Capacity of Well: 500 g.p.m. with 32 feet drawdown.

\_\_\_\_\_ g.p.m. with \_\_\_\_\_ feet drawdown.

Date of test June 2, 1947

If Flowing Well: Measured discharge \_\_\_\_\_ g.p.m. on \_\_\_\_\_  
(Date)

Shut-in pressure at ground surface \_\_\_\_\_ lbs. per sq. in. on \_\_\_\_\_  
(Date)

Water is controlled by \_\_\_\_\_  
(Cap, valve, etc.)

8. Casing: (Give diameter, commercial specifications and depth below ground surface of each casing size.)

11 inch diameter standard steel pipe from ground to 199 feet  
 10 inch diameter " " " from 152 to 109 feet  
 inch diameter from to feet  
 inch diameter from to feet

Describe and show depth of shoe, plug, adapter, liner or other details:

9. Perforated Casings or Screens:

Not available from to  
(Number per foot and size of perforations, or describe screen)  
 from to  
 from to  
 from to

10. Log of Well: (Describe each stratum or formation clearly, indicate if water bearing, and give thickness and depth as indicated.)

MATERIAL	Thickness (Feet)	Depth to Bottom (Feet)
Brown Sand	31	
Concrete pumped in brown sand by previous contractor	6	
Brown Sand	17	
Cemented gravel	37	
Loose sand and gravel - water bearing formation	12	
Sand and gravel - clay binder	10	
Hard cemented gravel	3	
Cement gravel	24	
Light sand with scattered gravel--water bearing formation	19	
Cemented gravel	14	
Hard cemented gravel	1	
Greenish blue clay	3	
Solid black rock	4	

If log of well is not available, give name and address of driller.

11. Infiltration Trench: Covered or open \_\_\_\_\_

Dimensions: Length \_\_\_\_\_ ft. Minimum depth \_\_\_\_\_ ft. Maximum depth \_\_\_\_\_ ft.

Bottom width \_\_\_\_\_ ft. Discharge \_\_\_\_\_ g.p.m. Date of test \_\_\_\_\_

12. Tunnel: Type of lining \_\_\_\_\_

Dimensions: \_\_\_\_\_  
(Length, course, and cross sectional size)

Position of water bearing stratum with reference to portal of tunnel \_\_\_\_\_

Log of tunnel: (Preceding table for log of well may be used, if desired. Give footage from portal and character of materials, as pertinent.)

13. Pumping Equipment:

(a) Pump Worthington Turbine (vertical) 4 stage Capacity \_\_\_\_\_ g.p.m.  
*(Make, type and size)*


(b) Motor U. S. Motor CFU 30 HP  
*(Type and horsepower)*

14. Location of area irrigated or to be irrigated, or place of use if for purposes other than irrigation.

Township North or South	Range E. or W. of Williamette Meridian	Section	Forty-acre Tract	Number Acres To Be Irrigated	Date of Reclamation
T15	R1E	3	SW 1/4 of NW 1/4	Industrial	1947

15. If the ground water supply is supplemental to an existing water supply, identification of any application for a permit, permit, certificate or adjudicated right to appropriate water made or held by the registrant.

Township 15 Range 1E W.M. 1  
North

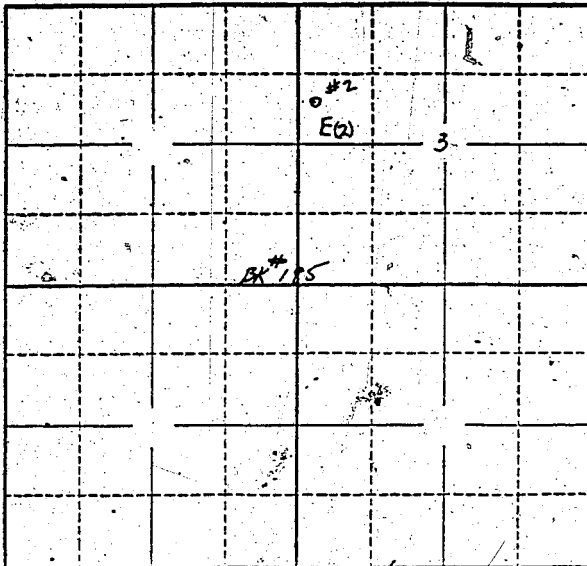

Locate well and acreage of irrigated land on plat.

Scale: 2" = 1 Mile

93'

STATE OF OREGON

County of Multnomah

I, James A. Melvin, being first duly sworn, do hereby certify that I have read the foregoing Registration Statement and that all of the items therein contained are true to the best of my knowledge and belief.

James A. Melvin Mech. Eng.  
(Signature of Registrant)

Subscribed and sworn to before me this 2 day of July, 1957

My commission expires 8/10/58

J. R. Sewerly  
(Notary Public)

(SEAL)

### CERTIFICATE OF REGISTRATION

STATE OF OREGON }  
County of Marion } ss.

This is to certify that the foregoing Registration Statement was received in the office of the State Engineer on the 11th day of July, 1958, at 1.00 o'clock P. M. and has been duly recorded in said office in Book No. 9 of Registration Statements on page GR-1886

Witness my hand this 26th day of January, 1959

Lewis A. Standley  
(State Engineer)

By \_\_\_\_\_ (Deputy)

GR-1886

\$20.00